



T 23 S R 3 W

1" = 2000'

- B. L. M. RESURVEYS - - - - -
- CORNERS RENEWED OR ESTABLISHED - - - - - ●
- CORNERS FOUND AND USED - - - - - ■
- CORNERS LOOKED FOR AND NOT FOUND - - - - - ○
- COUNTY BOUNDARY - - - - -
- LAST REPORT, LOOKED FOR NOT FOUND - - - - - *

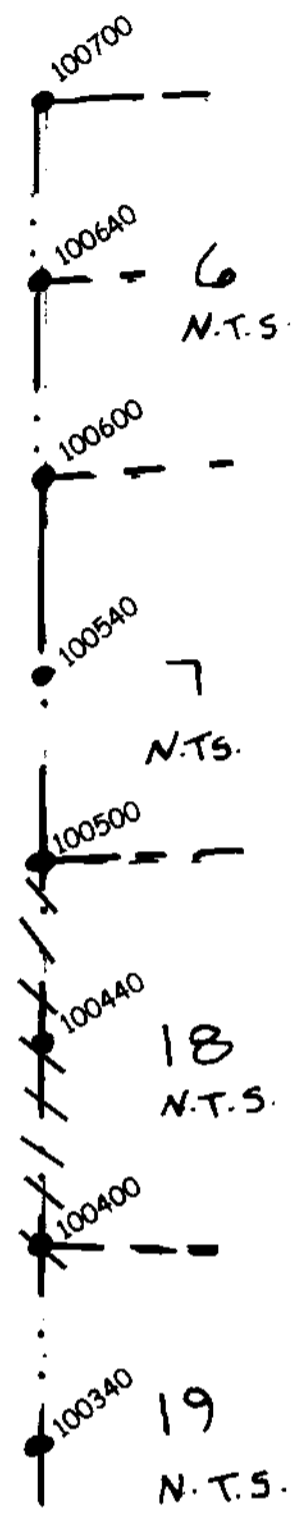

Lane County

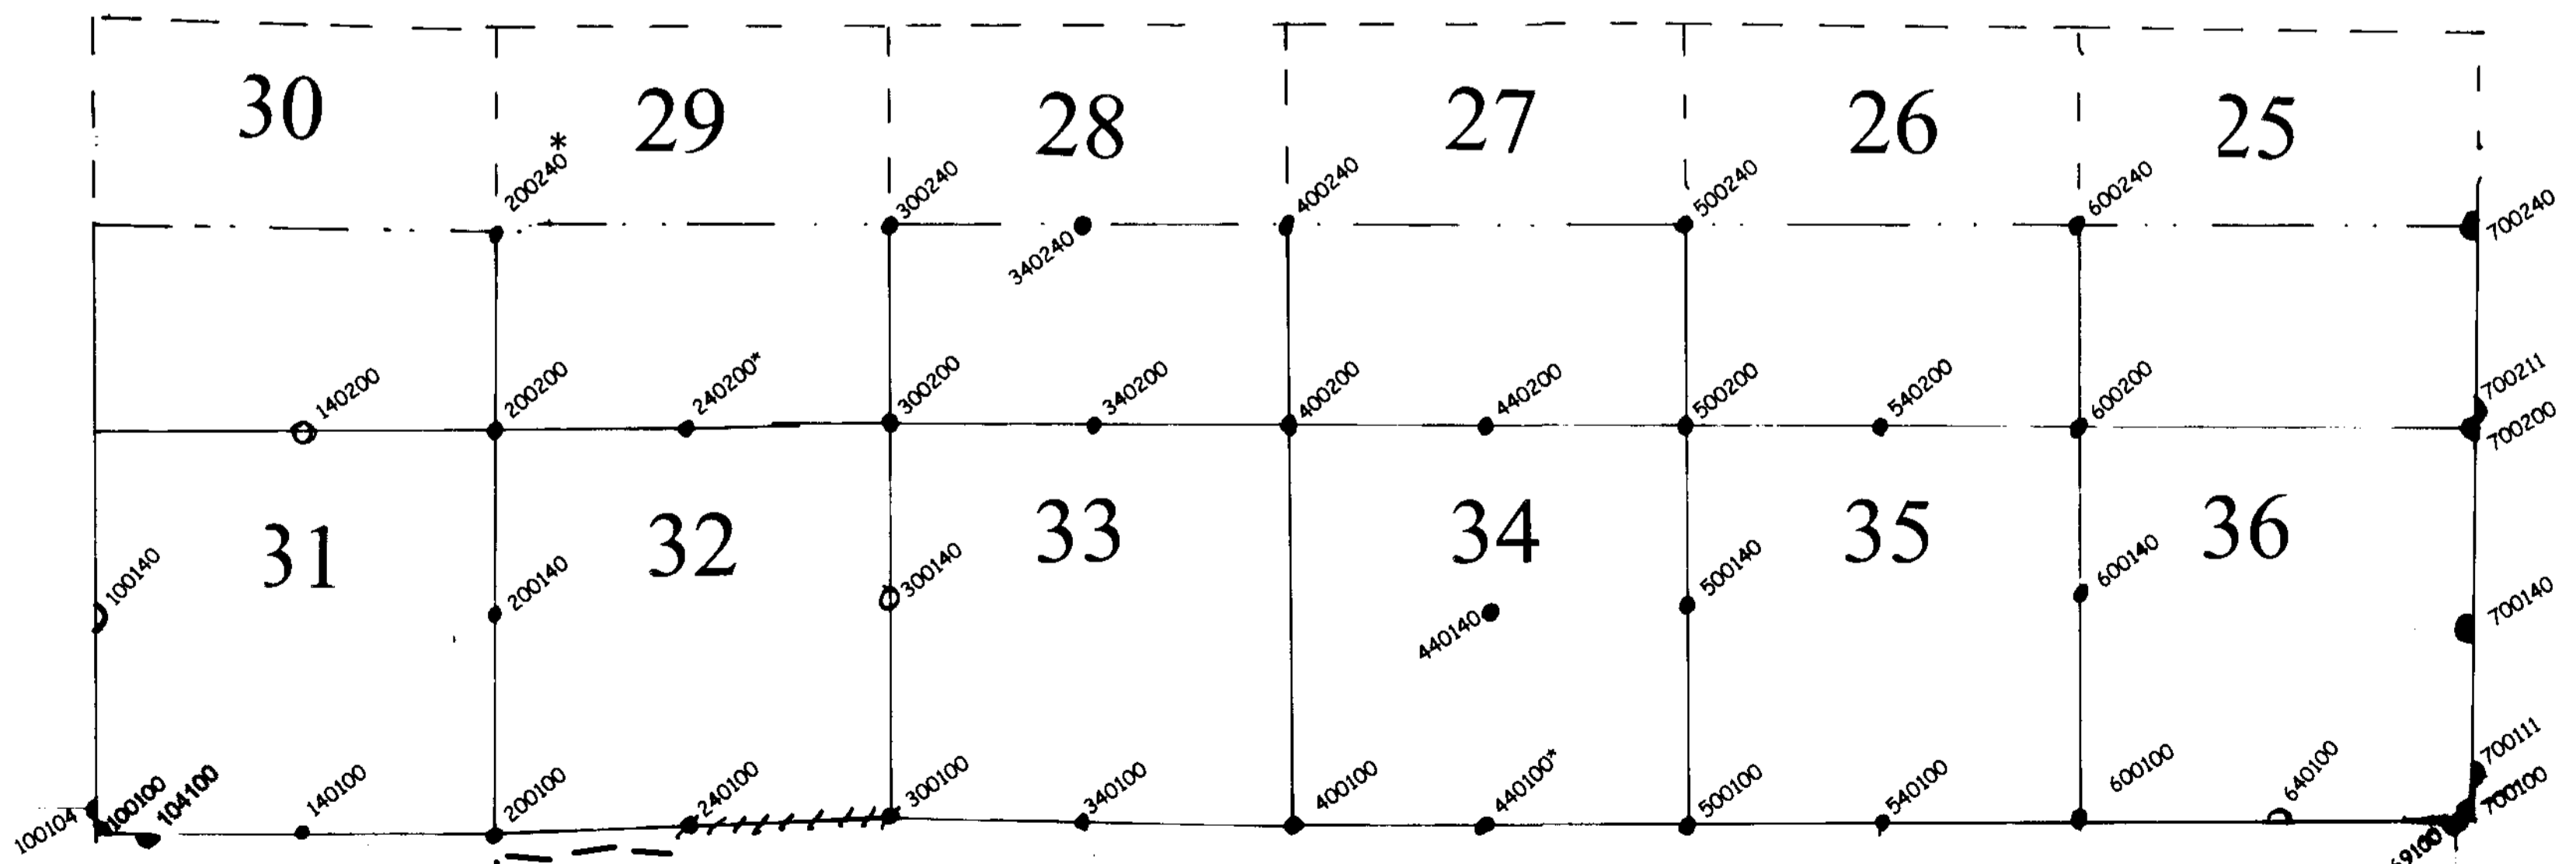

2014 BLM FIELD
 WORK SEE
 CS 42/404