

TOWNSHIP 24 RANGE 04 POINT IDENTIFIER # 500500

PRIMARY CORNER DESCRIPTION Cor Secs 10, 11, 14, & 15

Alias _____	Description _____
Alias _____	Description _____
Alias _____	Description _____
Alias _____	Description _____

Original - Oscar F. Thiel, Contract #658, May 1896 (DCSO records Vol. 7 Page(s) 3064)

Set an Alder post 3' long, 4' sq., 24" in the ground for cor., mkd: T24S S11 on NE, R4W S14 on SE; S15 on SW & S10 on NW faces with 4 notches on the S & 2 on E edges from which

- A Fir, 5" dia., bears N.74½°E., 56 lks., mkd: T24S R4W S11 BT.
- A Fir, 6" dia., bears S.64½°E., 54 lks., mkd: T24S R4W S14 BT.
- A Fir, 10" dia., bears S.58°W., 52 lks., mkd: T24S R4W S15 BT.
- A Fir, 6" dia., bears N.71°W., 76 lks., mkd: T24S R4W S10 BT.

Richard C. Grant - J. Chapman - D. Powell - W. Oilan - Jan. 3, 1958 - C.S. File 42/328-2

Corner set from 2 witness trees 1/3/58

- 6" Fir, green & standing, bears S.64½°E., 54 lks.
- Stump for the Fir which bears S.58°W., 52 lks., was cut high, cat face still visible, w/2 tags.
- No other trees available, area was logged & burned.

Set 1" x 30" iron pipe with brass cap mkd: 10, 11, 14, 15, T24S R4W

Douglas Co. Surveyors Office -Milo E. Godfrey, Deputy Co. Surveyor - Vernon Tracy - Mike Stone - Mar. 1963 - C.S. File 53/9-35

Found - Brass cap set by Grant in 1958.
High cut Fir stump, now 26", S.58°W., 34.3', chopped open & fd. good scribing "S".
No trace of any other OBTs

New BTs- 6" Hemlock, N.26°E., 84.7', mkd: S11 CS BT.
40" R.Cedar S.20½°E. 266.5', mkd: T24S R4W S15 CS BT
9" R.Cedar S.66°W., 198.0', mkd: T24S R4W S15 CS BT
No suitable trees near to NW

Corner lies approx. 35' North of small stream running SE.

BLM dependent resurvey by James E. Jelly, Cadastral Surveyor, under Group #979, surveyed May/Sept. 1979 (DCSO records Vol. 42 Page(s) 16382-83)


The cor. perpetuated & recorded by Byron in 1958 & Godfrey in 1963, monumented with an iron post, 1¼" dia., firmly set, projecting 10" above ground, with properly mkd. brass cap.
continued next page

PRIMARY CORNER DESCRIPTION Cor. Secs 10, 11, 14, & 15

Alias _____	Description _____
Alias _____	Description _____
Alias _____	Description _____
Alias _____	Description _____

from which the remains of an OBT
 A Sawed Fir stump, 26" dia., bears S.56¼°W., 52 lks., with fragmentary scribe marks visible on open blaze. (Rec. S.58°W.)
 and the remains of bearing trees mkd. by Godfrey
 A Hemlock, 12" dia., bears N.25°E., 128 lks., with healed blaze.
 A sawed Cedar stump, 45" dia., bears S.22°E., 402 lks., dist. with healed blaze.
 A Cedar, 14" dia., bears S.66°W., 300 lks., with healed blaze.
 and new bearing trees
 A Fir, 6" dia., bears N.38°E., 43½ lks., mkd. T24S R4W S11 BT.
 A Fir, 9" dia., bears S.64½°E., 124 lks., mkd. T24S R4W S14 BT.
 A Fir, 9" dia., bears N.17 3/4°W., 36½ lks., mkd. T24S R4W S10 BT.

BLM dependent resurvey by Wayne L. Rogers, under Group #1834 surveyed April 1997 - (DCSO records Vol. 52 Page(s) 20180)

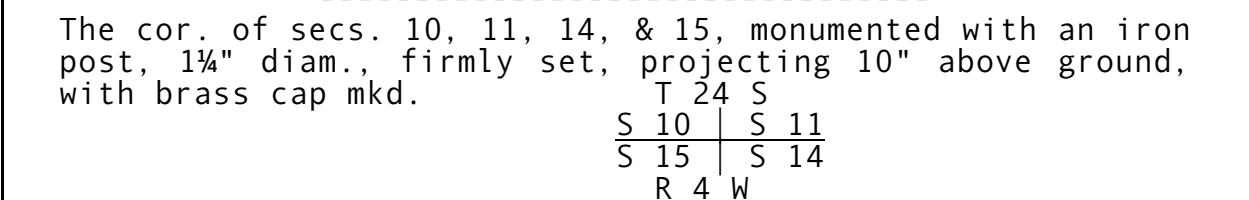

from which the remains of an original bearing tree
 A sawed fir stump, 23" diam., bears S.56¼°W., 52 lks., with fragmentary scribe marks visible on open blaze.
 and the remains of bearing trees marked by Godfrey
 A hemlock, 16" diam., bears N.25°E., 124 lks., with healed blaze. (Record, 128 lks.)
 A cedar stump, 35" diam., bears S.22°E., 402 lks., no marks visible.
 and the bearing trees marked by Jelley in 1979
 A fir, 10" diam., bears N.41°E., 42 lks., with healed blaze. (Record, N.38°E., 43½ lks.)
 A fir, 22" diam., bears S.64½°E., 124 lks., with healed blaze.
 A fir, 21" diam., bears N.17 3/4°W., 36½ lks., with healed blaze.
 and a new bearing tree
 A fir, 17" diam., bears S.61½°W., 148 lks., mkd. T24S R4W S15 BT.

continued next page

TOWNSHIP 24 RANGE 04 POINT IDENTIFIER # 500500

PRIMARY CORNER DESCRIPTION Cor. Secs. 10, 11, 14, & 15

Alias _____	Description _____
Alias _____	Description _____
Alias _____	Description _____
Alias _____	Description _____

This corner was recorded by James E. Jelley, as perpetuated and recorded by James W. Byron, Deputy County Surveyor, in 1958. The corner was actually perpetuated by Richard C. Grant, Registered Professional Engineer No. 2807, in 1958. The corner is located 0.45 chs. north of Boyd Creek, 10 lks. wide, course S.55°E.

Troy Rambo - For: Seneca Jones Timber Co. - 8/2004 - M145-32

Found - Brass cap
A 24" DF with a healed face - N.17¾°W., 26½ lks.
An 11" DF with a healed face - N.38°E., 43½ lks.
An 18" DF with a healed face - S.61°W., 149 lks.
Set - A 5½' steel post 1.0 ft. West. Did not have the notes for this corner at the time it was visited. So I did not search for the other record BTs.