


T 25 S R 01 E

B.L.M. RESURVEYS - - - - - OR / / / / /
CORNERS RENEWED OR ESTABLISHED - - - - - ●
CORNERS LOOKED FOR AND NOT FOUND - - - - - ○
CORNERS RENEWED - LAST REPORT NOT FD - - - - - *
COUNTY BOUNDARY - - - - -



T 25½ S R 01 E

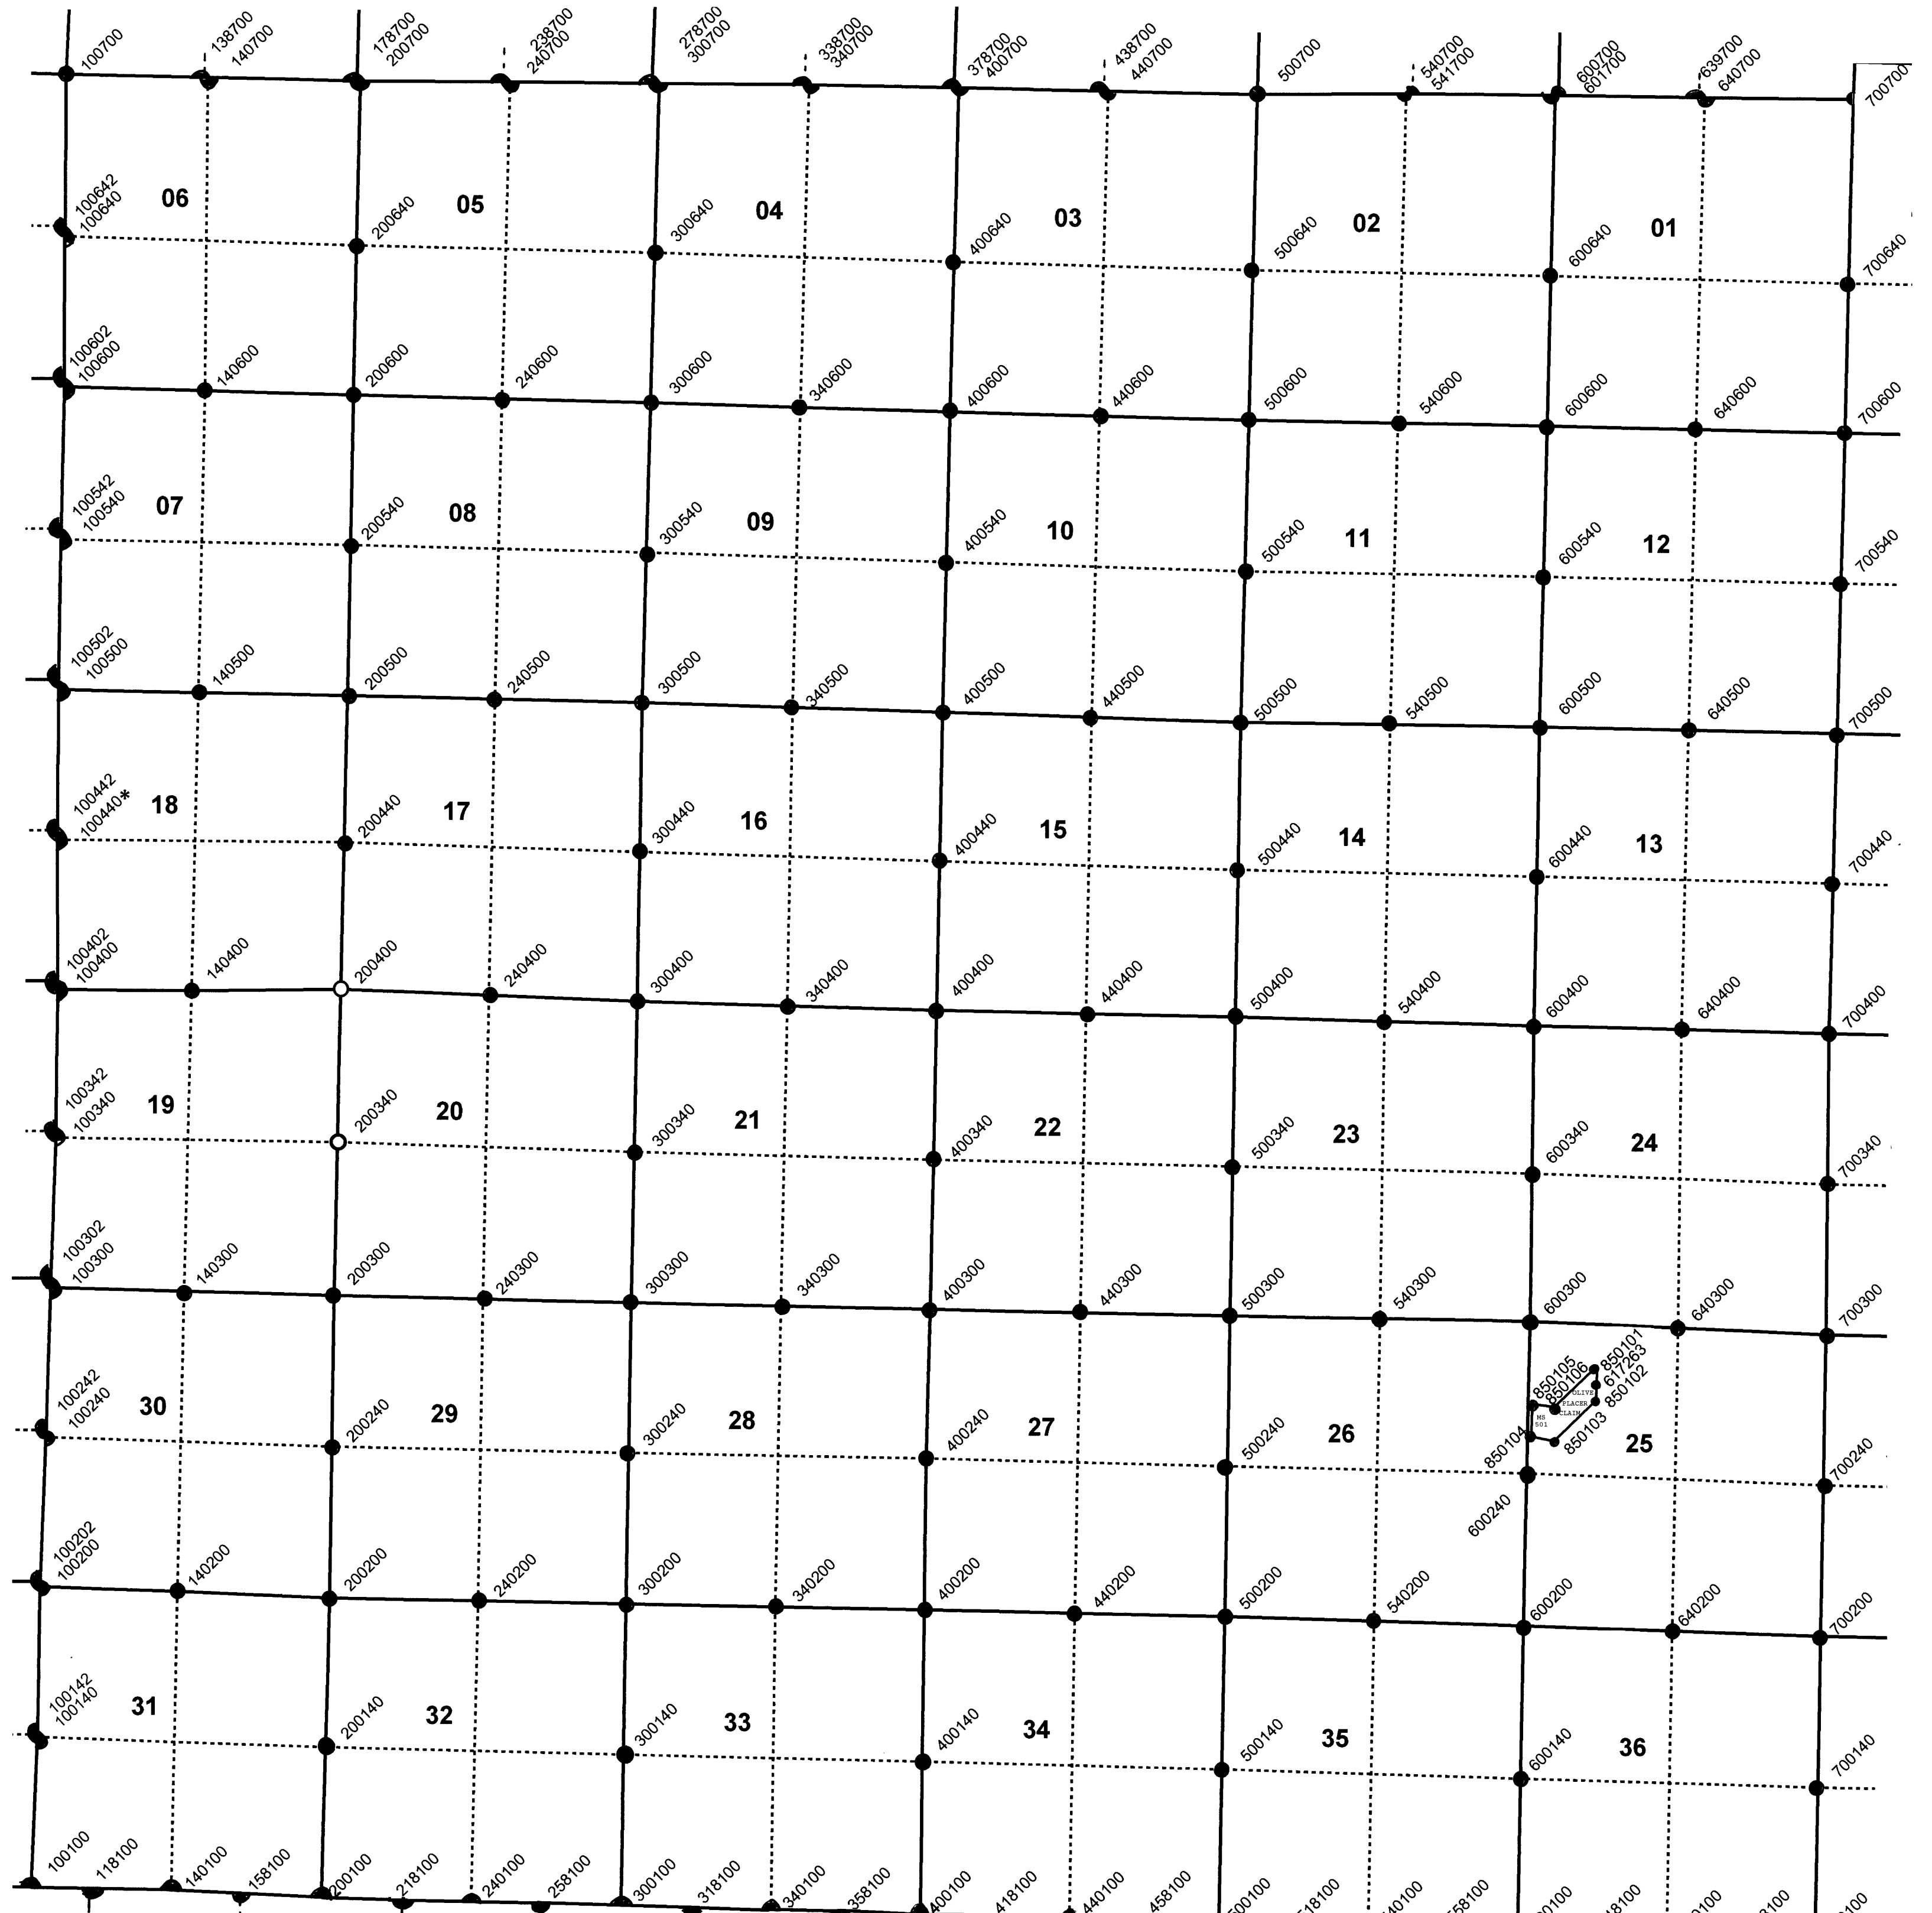