

TOWNSHIP 26 RANGE 05 POINT IDENTIFIER # 240100

PRIMARY CORNER DESCRIPTION 1/4 Cor. for S 32; & S 5 of T27-5

Alias _____ Description _____
Alias _____ Description _____
Alias _____ Description _____
Alias _____ Description _____


Original - Elder & Gile, Contract #31 dated April, 1853

Set 1/4 sec. post, from which
A W.Oak 6" dia. bears N.55°W., 42 lks.
A Y.Oak 24" dia. bears S.3°E., 146 lks.

James W. Byron, D. McFarland - March 23, 1962 - C.S. 49/125

Found - Both orig. BTs.:
6" now 12" W.Oak, N.55°W., 27.7 ft. previously
opened, shows good scribing "1/4".
24" now 30" B.Oak, snag S.7°E., not S.3°E., 92.4 ft.
not 96.4 ft., shows good scribing.

Fence Corner thus: x

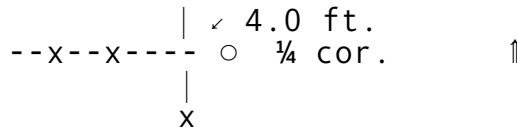

Set - Brass cap at 1/4 cor. mkd. 1/4 $\frac{S\ 32}{S\ 5}$ T26S R5W
T27S

County Surveyor's Office, 1962.
New BTs - Rescribe orig. now 12" W.Oak N.55°W., 27.7 ft.
"CS BT"
7" W.Oak ~~S.18°W.~~, S.19°W., (per research 6/30/2022)
21.4 ft. scribed 1/4 S5 CS BT.

Found OK per B.Rogers, May 1987, M 104 - 40
Found OK, Steven Ness, Nov. 1991, M 114 - 59

Fd. Ok by Heimbürger 9/2008, M157-3A&B. This corner was used
to proportion the corners 240600;300500;300600 these corners
were calculated but not set on this survey.