

Alias _____ Description _____
Alias _____ Description _____
Alias _____ Description _____
Alias _____ Description _____


GLO Resurvey by Morris Wygant, Compassman for Zachariah Derrick, U.S. Deputy Surveyor, Under Contract #779, dated Feb. 7, 1908 - (DCSO records Vol. 12 Page(s) 4956)

At point of intersection (330 lks. S.0°21'W. of sec. cor. 24 & 25), I set a Laurel post 3 ft. long, 4" sq., 24" in the ground for closing cor. for secs. 19 and 30, marked CC T27S R2W on E.; S19 on N. and S30 on S. face, with 2 grooves on S. and 4 grooves on N. face, from which
A Fir 30" dia., bears N.65°30'E., 34 lks. dist. mkd. T27S R2W S19 BT.
A Fir 36" dia., bears S.64°E., 74 lks. dist. mkd. T27S R2W S30 BT.

Douglas County Surveyors Office - Vernon "Ray" Tracy and crew April 22, 1969 - C.S. File 54/40-163

Found - Orig. 30" now 40" Fir N.65½°E., 22.4 ft., alive, shows good scar.
Orig. 36" Fir S.64°E., 48.8 ft. now badly decayed remains of stump. Blaze intact, shows "T27S R2W S30 BT" scribe.

At point for closing corner, Set 1" I.P. and brass cap mkd:
County Surveyors Office

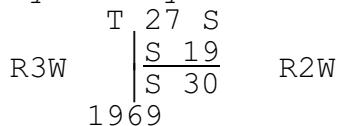

New BTs- 8" D.Fir N.76°E., 10.6 ft. mkd. T27S R2W S19 CC CSBT
8" D.Fir S.27°E., 15.2 ft. mkd. T27S R2W S30 CC CSBT
Corner lies on SW. slope and approx. 217.8 ft. South of the sec. cor. for 24 and 25 of T27S R3W.
(This is now an amended closing corner per Geisler, M 90-17)

Survey by Ronald Geisler - For: Champion International Co. - June/Aug. 1985 - M 90-71

Set a 2½" alum. cap on a 2½" x 30" alum. flared pipe mkd. PLS 1988., from which
11" Fir bears N.54°E., 15.2 ft. scribed T27S R2W S19 CC BT
7" Fir bears S.28°E., 20.6 ft. scribed T27S R2W S30 CC BT.
An amended closing corner bears S.88°59'33"E., 14.38 ft. dist. (See above County Corner)

continued next page

Alias _____ Description _____
Alias _____ Description _____
Alias _____ Description _____
Alias _____ Description _____

BLM dependent resurvey by A. Bert Skeesick & Timothy J Moore, Cadastral Surveyors & Robert H Browning, Survey Technician, under Group No. 1968, surveyed Aug. 2003/July 2004 - (DCSO records Vol. 56 Page(s) 22035-6)

The closing cor. of secs. 19 and 30, T27S R2W established by Geisler, in 1985, and is accepted as the cor., monumented with an aluminum post, 2½" dia., firmly set, projecting 4 ins. above the ground, with aluminum cap (properly) mkd. from which bearing trees mkd. by Geisler

A fir snag, 12" dia., bears N.52¾°E., 15.1 ft., with scribe marks T27S R2W S19 CC BT visible on a partially healed double blaze.

A fir, 9" dia., bears S.30½°E., 20.9 ft., with scribe marks 7S R2 visible on a partially healed blaze. and a new bearing tree

A fir, 20" dia., bears N.44½°E., 23.4 ft., mkd. T27S R2W S19 CC BT.

From this corner, the original closing cor. of secs. 19 and 30, T27S R2W remonumented by the Douglas County Surveyors Office in 1969, amended by Geisler, in 1985, bears S.88°59'02"E., 14.31 ft., monumented with an iron post, 1½" dia., firmly set, projecting 10" above the ground, with brass cap (properly) mkd.

from which the remains of the original bearing trees

A fir, 44" dia., bears N.65½°E., 22.4 ft., with a healed blaze.

A sawed and decayed fir stump, size indeterminate, bears S.64°E., 48.8 ft., with no marks visible.

and bearing trees mkd. by the Douglas County Surveyors Office

A fir, 10" dia., bears N.76¾°E., 10.1 ft., with a healed blaze.

A fir, 11" dia., bears S.25½°E., 15.1 ft., with a healed double blaze.