


See attached diagram of BLM 2024 resurvey

Sec 13

T 27 S R 4 W

1" = 2000'

B.L.M. RESURVEYS - - - - -
 CORNERS RENEWED OR ESTABLISHED - - - - - ●
 CORNERS FOUND AND USED - - - - - ■
 CORNERS LOOKED FOR AND NOT FOUND - - - - - ○
 CORNER RENEWED - LAST REPORT NOT FD - - *

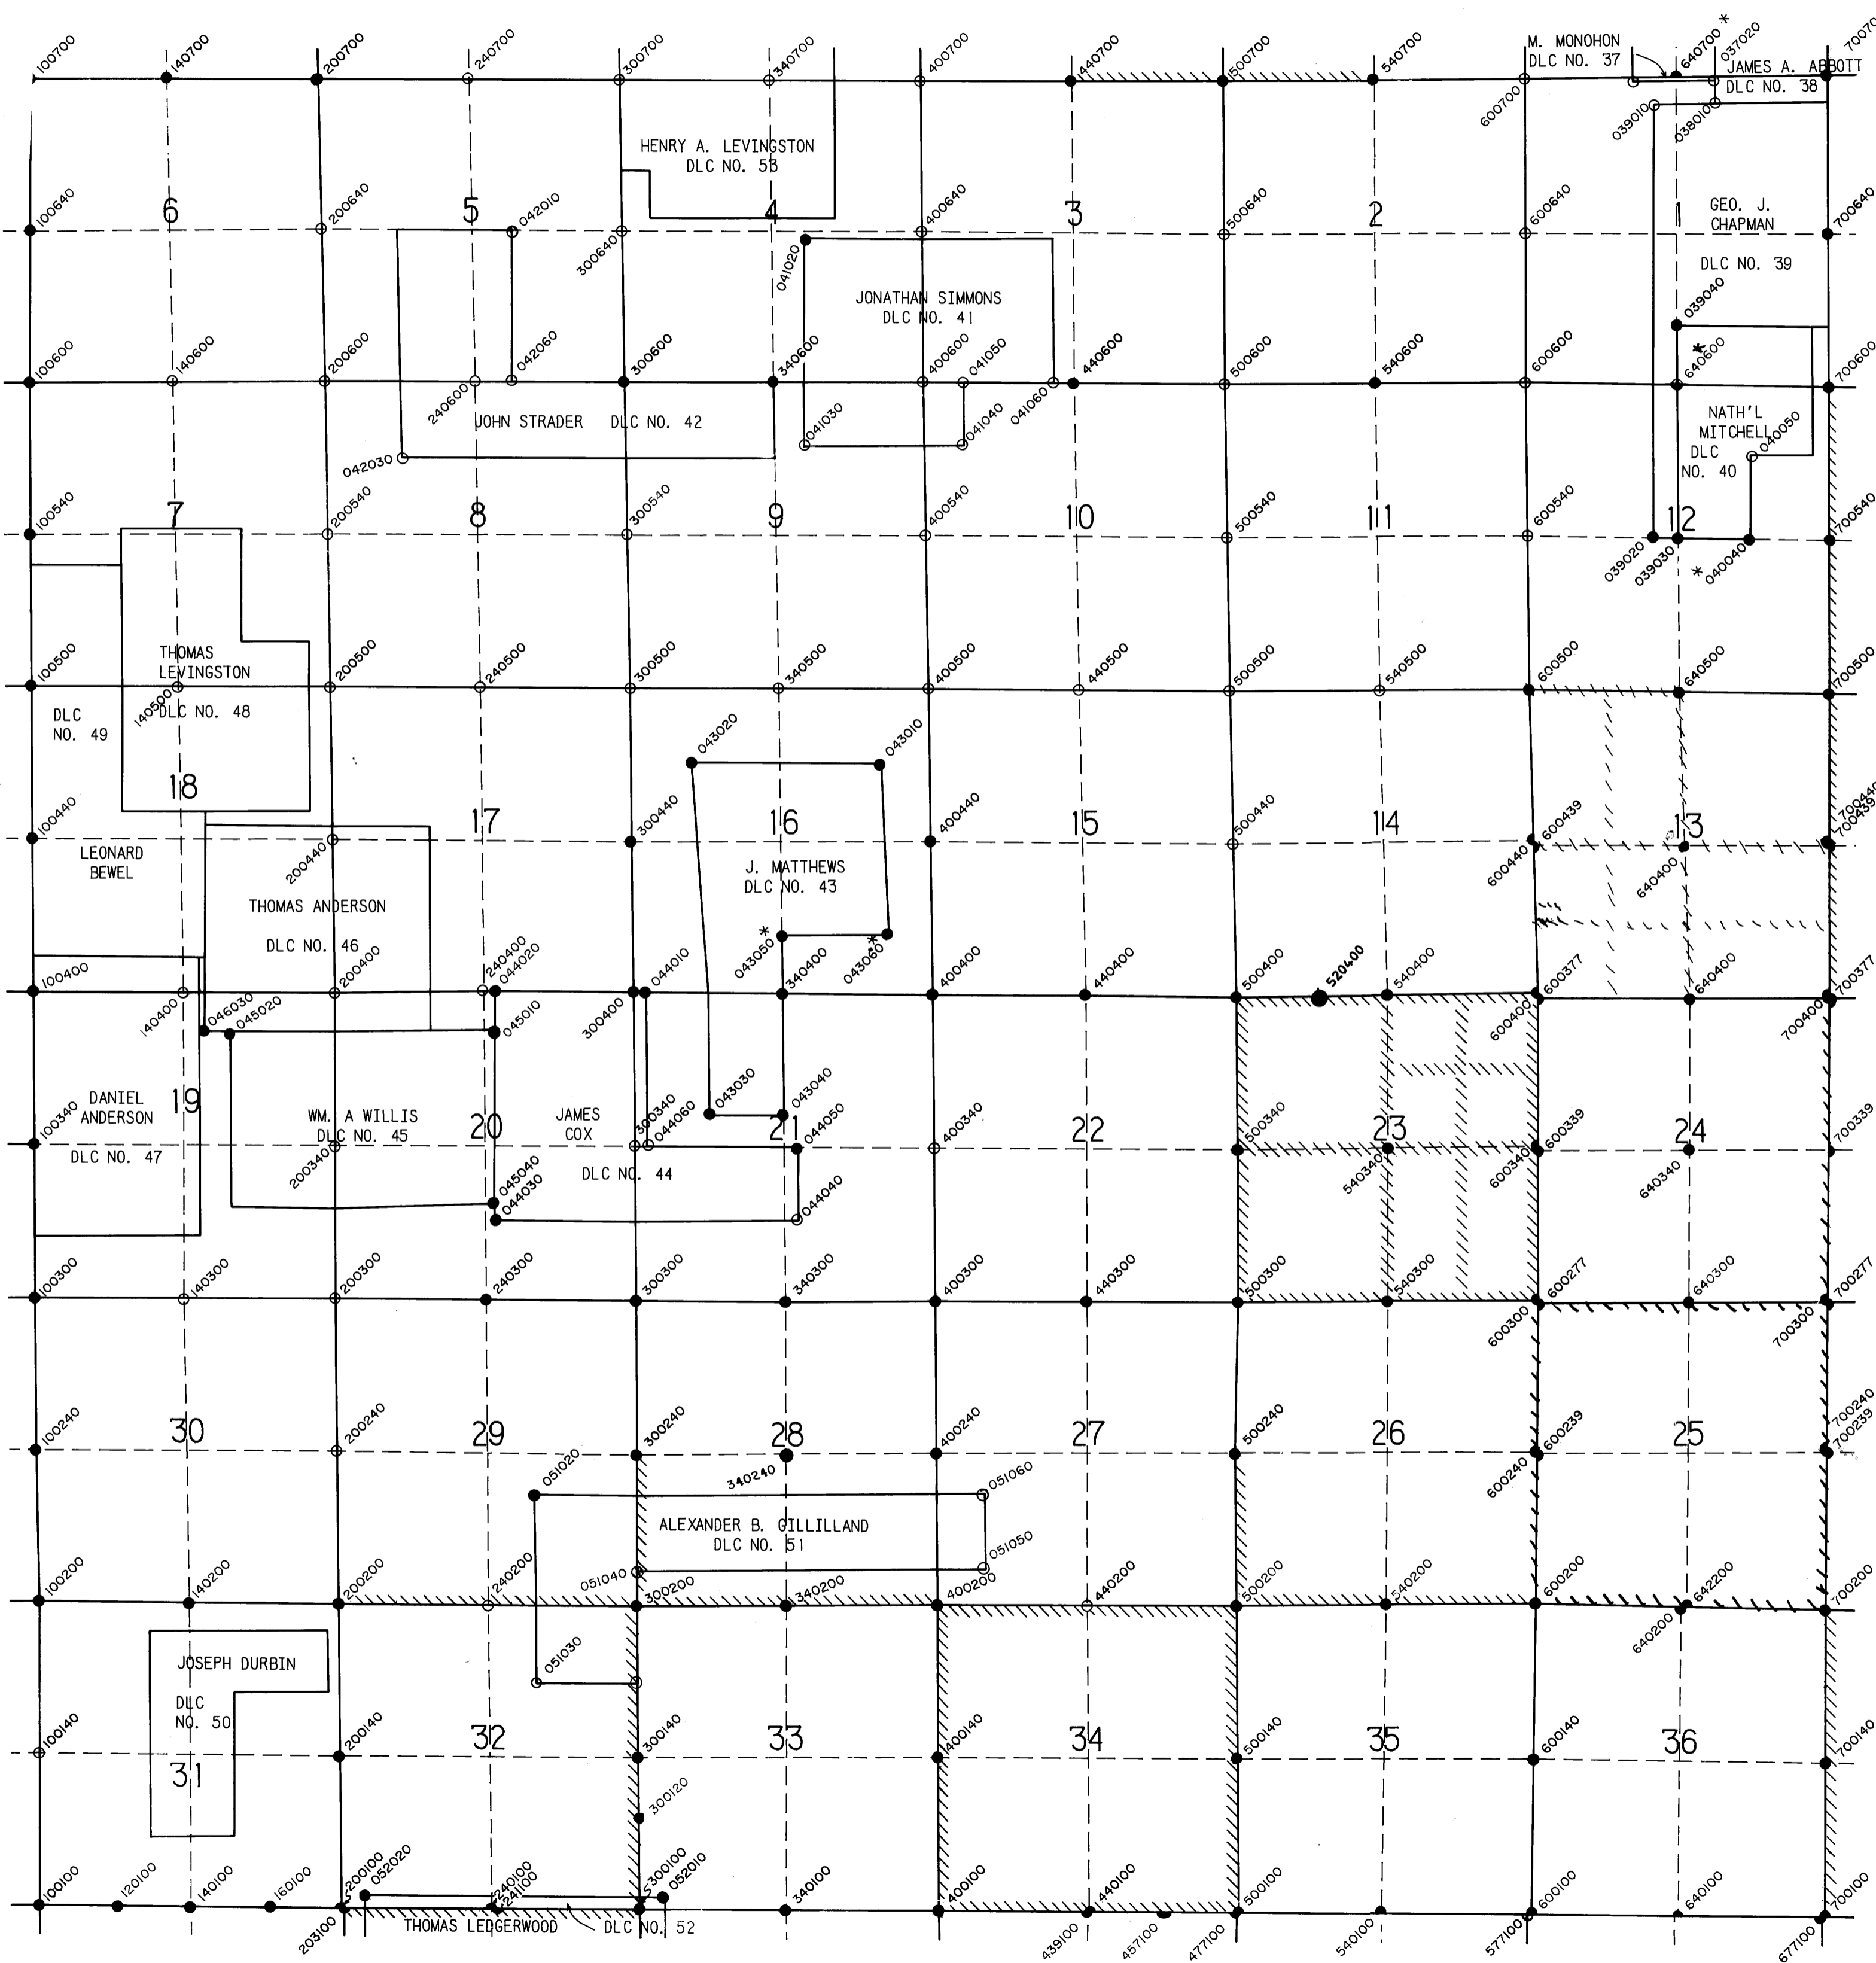

Rec'd 10/30/2024



United States Department of the Interior

BUREAU OF LAND MANAGEMENT
Oregon State Office
1220 SW 3rd Ave., Portland, Oregon 97204
blm.gov/or



Ronald A. Quimby
Douglas County Surveyor
1036 SE Douglas Avenue
Roseburg, OR 97470

Dear Ronald A. Quimby:

This is to inform you that a cadastral survey crew under the direction of Kevin G. Mulder, Cadastral Surveyor, will be dependently resurveying portions of the subdivisional lines and subdivision of section lines of section 13, T. 27 S., R. 4 W., Willamette Meridian, Oregon, as provided by Special Instructions for Group No. 3070, Oregon.

In order to properly execute this work, it may be necessary for our party chief to contact you for pertinent information. Any assistance you may be able to provide will be appreciated.

The Special Instructions Diagram is enclosed for your information. Please contact Kevin G. Mulder at 541-618-2230 if you have any questions regarding this survey.

Sincerely,

**ROBERT
FEMLING**

Digitally signed by
ROBERT FEMLING
Date: 2024.10.24
13:04:32 -07'00'


Robert W. Femling
Chief Cadastral Surveyor of Oregon

Enclosure (1)



INTERIOR REGION 9 • COLUMBIA-PACIFIC NORTHWEST
IDAHO, MONTANA, OREGON*, WASHINGTON
* PARTIAL

CS 42/404

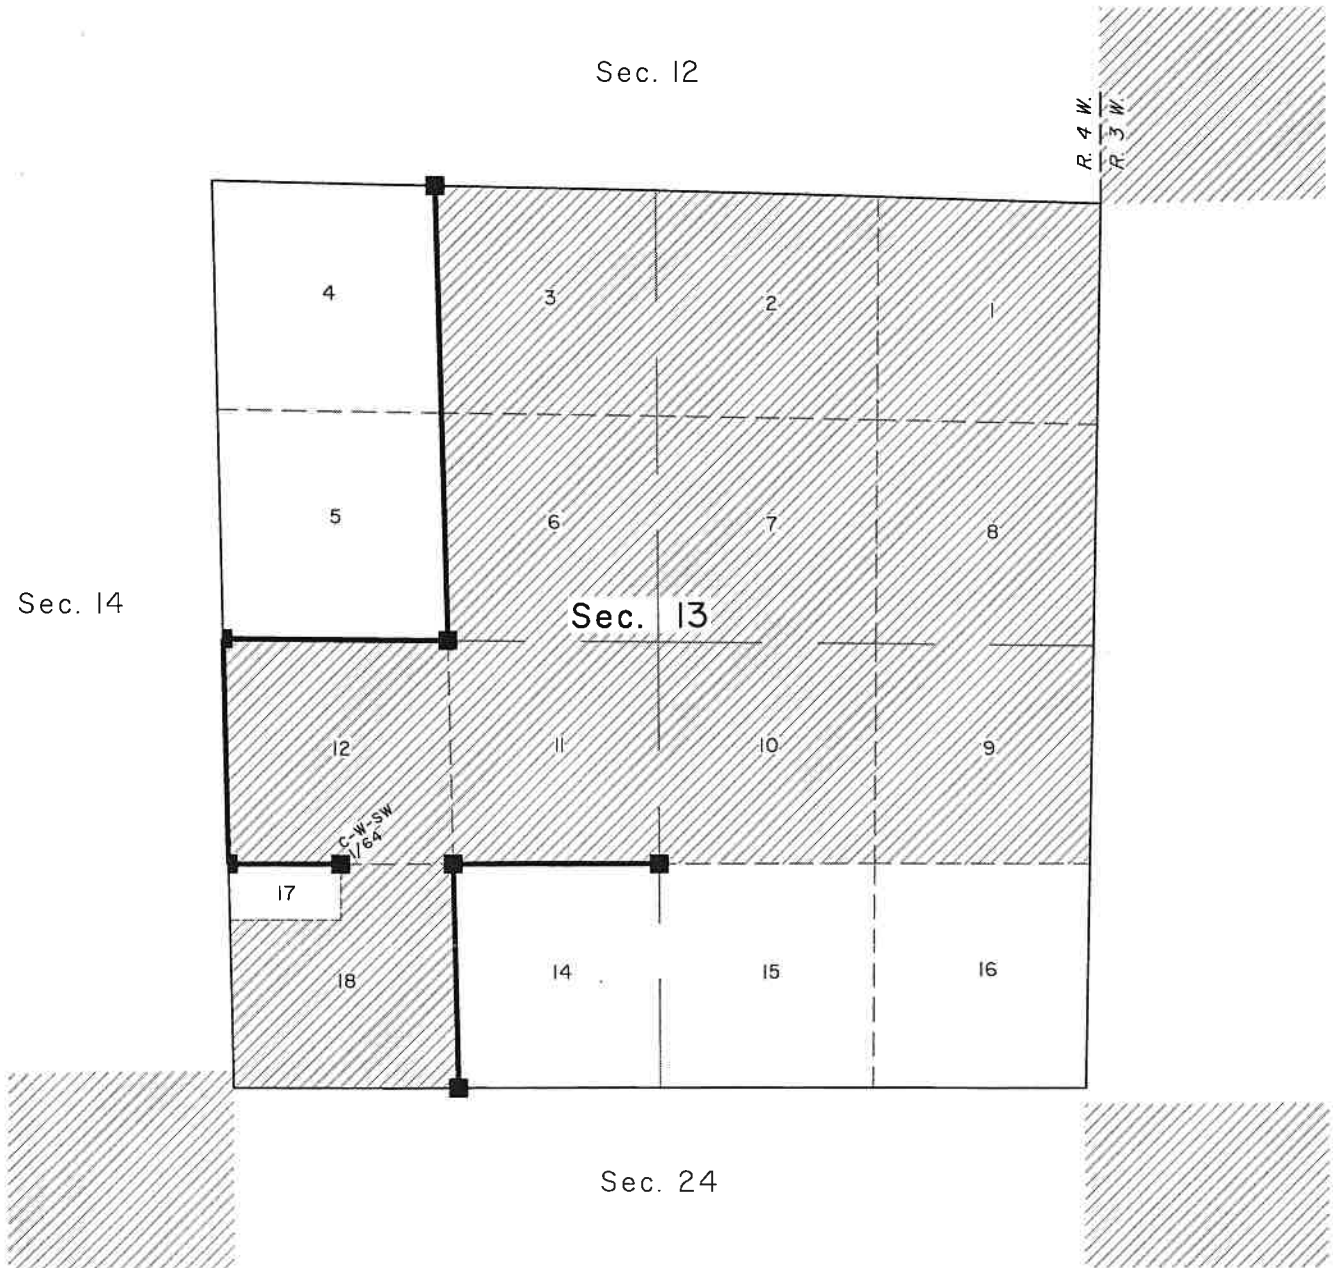SPECIAL INSTRUCTIONS DIAGRAM
TOWNSHIP 27 SOUTH, RANGE 4 WEST, WILLAMETTE MERIDIAN
 GROUP No. 3070, OREGON



 Public Land Administered by BLM

 Corner previously established or reestablished
 Line to be surveyed or resurveyed