

TOWNSHIP 27 RANGE 06 POINT IDENTIFIER # 200400

PRIMARY CORNER DESCRIPTION Sec Cor for 17, 18, 19, & 20

Alias \_\_\_\_\_ Description \_\_\_\_\_  
Alias \_\_\_\_\_ Description \_\_\_\_\_  
Alias \_\_\_\_\_ Description \_\_\_\_\_  
Alias \_\_\_\_\_ Description \_\_\_\_\_

Original - Elder & Gile, Contract #31 dated April, 1853

-----  
Set post cor. to Secs. 17, 18, 19 and 20, from which  
A Y.Oak, 16" dia. bears N.41¼°E., 298 lks. dist.  
A W.Oak, 12" dia. bears S.86¼°E., 271 lks. dist.  
A Y.Oak, 14" dia. bears N.1½°W., 342 lks. dist.  
No tree near, SW.


F.C. Frear - Wit. P.D. Wolford; J.H. Wolford  
March 26, 1935 - M 8 - 40 & 46; "Old" Ren. Cor. Vol. 1 Pg. 93

-----  
I set 3 x 3 x 30" Oak stake from two old BTs, from which the  
new bearing trees are as follows:  
Red Fir 16" dia. bears S.51°E., 12.9 ft.  
A Laurel 12" dia. bears S.61½°W., 44.9 ft.  
B.Oak 14" dia. bears N.86°W., 43.8 ft.  
B.Oak 10" dia. bears N.32¾°E., 41.3 ft.

James W. Byron, Deputy - Milo Godfrey; Clete Putnam - August  
16, 1960 - C.S. File 49/55-4

-----  
Found - All of Crocker's BTs:  
16" now 24" Fir stump S.51°E., 12.9 ft., I open and  
find good scribing.  
12" now 16" Laurel S.61¾°W., 44.9 ft. shows scribe  
marks.  
10" now 14" B.Oak N.32¾°E., 41.3 ft. face rotted.  
14" now 24" B.Oak N.86°W., 43.8 ft. shows good scar.  
I do not open.

Fence thus

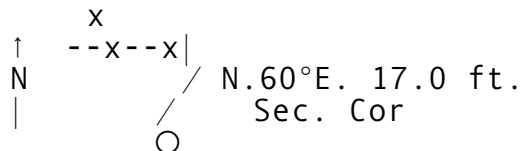

Set - Brass cap at corner mkd: County Surveyor's Office  
1960 S18 | S17

S19 | S20      T27S R6W

New BTs - 6" R.Fir bears N.13°E., 13.5 ft. scribed S17 T27S  
R6W CS BT.  
10" R.Fir bears S.58½°E., 41.7 ft. scribed S20 T27S  
R6W CS BT.

Found OK by D. Bentz, Nov. 1991 - M114-19  
Found OK by D. Edwards, June 2000 - 2000-0052  
Fd. Ok by Ron Quimby, 9/2006 - M151-40