

PRIMARY CORNER DESCRIPTION No. Sec. Cor. for 2 & 3 only

Alias _____	Description _____
Alias _____	Description _____
Alias _____	Description _____
Alias _____	Description _____

GLO survey by Dennis Hathorn, Deputy Surveyor under Contract #57, dated April 12, 1855 - (DCSO records Vol. 14 Page(s) 5783)


-----  
 Set post cor. secs. 2 and 3, from which  
 A Hemlock 12" dia., bears S.80°E., 20 lks.  
 A Hemlock 8" dia., bears S.45°W., 23 lks.

BLM Resurvey by C. Albert White; John M. Jelley; James E. Jelley, Cadastral Surveyors, Under group #466, Surveyed Sept/Oct. 1961 - (DCSO records Vol. 30 Page(s) 12859)

-----  
 The standard corner of secs. 2 and 3, determined at record bearing and distance from the remaining original bearing tree:

A Hemlock 20" dia., fallen and rotted, bears S.45°W., 23 lks. dist., mkd. with a reversed B, on opened blaze. This corner now becomes also the eastern terminus and corner of sec. 34, T27½S R8W.

At the corner point  
 Set an iron post, 28" long, 2 1/2" dia., 24" in the ground, with brass cap mkd: A P

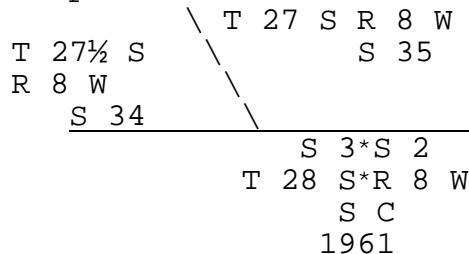

from which new bearing trees:  
 A Cedar 28" dia., bears S.15°E., 75 lks. dist. mkd. T28S R8W S2 SC BT.  
 A Fir 25" dia., bears S.84¼°W., 23 lks. dist., mkd. T28S R8W S3 SC BT and cruiser marks in the bark.  
 A Hemlock 10" dia., bears N.88°W., 114 lks. dist., mkd. T27½S R8W S34 BT.  
 A Hemlock 10" dia., bears N.11¼°W., 26 lks. dist., mkd. T27S R8W S35 AP BT.  
 The corner is located 55 lks. N. of a creek, 5 lks. wide, course S.85°E.

Fd. Ok by Tony Hostetter - Aug. 2002 - M140-72  
 Fd. Ok by Gary Smithers, June 2007 - M153-42

continued next page

TOWNSHIP 28 RANGE 08 POINT IDENTIFIER # 500700

PRIMARY CORNER DESCRIPTION No. Sec. Cor. for 2 & 3 only

Alias	_____	Description	_____
Alias	_____	Description	_____
Alias	_____	Description	_____
Alias	_____	Description	_____

Ron Rice, NW Land Surveying - June 2013 - C.S. File 65/78-51  
-----

Condition report only

Found - 3¼" BLM brass cap, dated 1961, with the following accessories:

36" D.Fir bears S.84°W., 15.1 ft. - healed face

16" Hem. stump bears N.11°E., (record N.11°W.) 17.1 ft. - healed face

16" Hem. bears N.88°W., 75.2 ft. - healed face

34" R.Cedar bears S.15°E., 49.5 - healed face

Note - Corner has steel post adjacent to it. All BTs have red painted bands and yellow tags.

Compass Declination 16° East