

PRIMARY CORNER DESCRIPTION East ¼ cor. to sec. 13, only

Alias _____ Description _____
Alias _____ Description _____
Alias _____ Description _____
Alias _____ Description _____

Original - Dennis Hathorn, Deputy, Contract #57 dated
April 12, 1855 (DCSO records, Vol. 16 Page 6570)

Set ¼ sec. post, from which
A B. Oak, 12" diam., bears N.54°W, 30 lks.
A Fir, 24" diam., bears N.44°E, 28 lks.

Re-establishment of corners - Fred Mensch , U.S. Deputy
Surveyor - under date of April 18, 1924 (DCSO Vol 14 Pg 6012)

Intersect the Hathorn ¼ sec. cor. of secs. 13 & 18, located
by measurement from the original bearing trees. The marks
are grown over, but the blazes are plain.

At the exact cor. point
Set an iron post, 3 ft long, 1" diam., 28" in the ground, for
¼ sec. cor. of sec. 13 only, with brass cap marked

¼S13|
1924

from which (the original bearing trees)
A fir, 30" diam., bears N.45°E., 28 lks., (not N.44°E.)
A B. Oak, 14" diam., bears N.52°W., 30 lks., (not
N.54°W.)

New bearing trees:
A fir, 16" diam., bears S.52°W., 19 lks., mkd. ¼ S 13 BT.
A fir, 8" diam., bears N.87°W., 41 lks., mkd. ¼ S 13 BT.

James W. Byron, Dep. Co. Surveyor - John Powell and Dale
Mcfarland - May/July 1962 - C.S. 49/139-74

Found - Brass cap at corner & SW. BT., shows good scar.
Find low cut stump that checks N.87°W., not S.87°W.

New BT:
9" R. Fir, bears N.87½°W., 16 ft. scribed ¼ S13 CS BT

BLM resurvey by Charles E. Akin, Jr.; James E. Jelley,
Cadastral Surveyors and Bruce A. Shaner, RLS #430, under
Contract #52500-CT5-1117 - Surveyed June 1973/April 1976
Under Group #'s808; 858; 860, - (DCSO records Vol. 39 Page(s)
15778-79)

The ¼ sec. cor., monumented with an iron post 1" dia., firmly
set, projecting 12" above ground with brass cap mkd in 1924,
from which the remains of the original bearing trees:

A Fir stump 30" dia., bears N.45°E., 28 lks. dist., with
healed blaze.

A root hole bears N.52°W., 30 lks. dist. with a down and
decayed Oak alongside size indeterminate, no marks
visible. (Cont. Next Page)

TOWNSHIP 29 RANGE 08 POINT IDENTIFIER # 700440

PRIMARY CORNER DESCRIPTION East 1/4 cor. to sec. 13, only

Alias _____ Description _____
Alias _____ Description _____
Alias _____ Description _____
Alias _____ Description _____


and the remains of bearing trees by Mensch:
A Fir 18" dia., bears S.52°W., 19 lks. dist., with healed blaze.
A Fir stump 8" dia., bears N.87°W., 41 lks. dist., with scribe marks BT visible on opened blaze.
and the remains of a bearing tree mkd. by Byron in 1962:
A root hole bears N.87½°W., 24 lks. dist., with a down Fir alongside 10" dia., with scribe marks 1/4 S13 CS visible on open blaze.
and a new bearing tree:
A Fir 10" dia., N.32°W., 23 lks. dist., mkd. 1/4 S13 BT.

Larry E. Monrean, Do. Co. Surveyors Office - P.L. Earle & K. Cheney - Jan/Feb 1977 - C.S. 59/29-19

Found -1" I.P. approx. 1 ft above ground with 1924 GLO brass cap properly stamped. From which:
A 24" now 34" Fir stump bears N.47½°E., 18.5 ft. to face, 19.5 ft to center (orig. N.44°E., 1924 rec. N.45°E).
A 16" now 19" Fir, bears S.54½°W., 12.5 ft. (1924 Rec. S.52°W.) Tree has well healed single blaze.
A 8" now 10" Fir stump, bears N.85°W., 26.4 ft. (1924 Rec. N.87°W., 27.1 ft.) Stump rotted "BT visible.
A 9" now 10" R. Fir bears N.87½°W., 16 ft. Tree is tipped out, partially rotted. Open blaze, scribe visible "1/4 S13 C.S."
A 10" Fir, bears N.32°W., 15.2 ft. Tree has open single blaze, scribed "1/4 S 13 BT". (1975 survey).

Douglas Co. Surveyors Office - R.B. Kimberling; P.L. Earle - crew - May 31, 1978 - C.S. File 60/11-13

1/4 CORNER TO BE LOST
Set a 1" x 36" I.P. with brass cap, set 4" above ground mkd:
"Douglas County Surveyor"

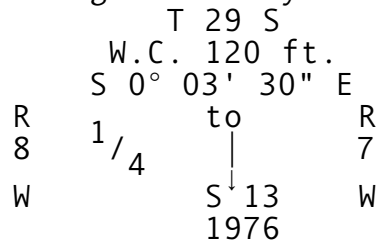

New BTs- A 7" W.Fir bears S.62½°W., 6.5 ft.
An 8" W.Fir bears N.36°W., 2.7 ft.
I double blaze and scribe both trees "WC 1/4 S13 CS BT".