


TOWNSHIP 30 RANGE 02E POINT IDENTIFIER # 700400

PRIMARY CORNER DESCRIPTION East Cor. Secs. 13 & 24, only

Alias \_\_\_\_\_ Description \_\_\_\_\_  
Alias \_\_\_\_\_ Description \_\_\_\_\_  
Alias \_\_\_\_\_ Description \_\_\_\_\_  
Alias \_\_\_\_\_ Description \_\_\_\_\_

GLO survey by Herbert N Raymond, U.S. Cadastral Engineer, under Special Instructions dated Dec. 27, 1920 & Sept. 9, 1927 - (DCSO records Vol. 26 Page(s) 11047-8)

-----  
Set an iron post, 3 ft. long, 2" dia., 32" in the ground, for cor. of secs. 13 & 24, with brass cap mkd

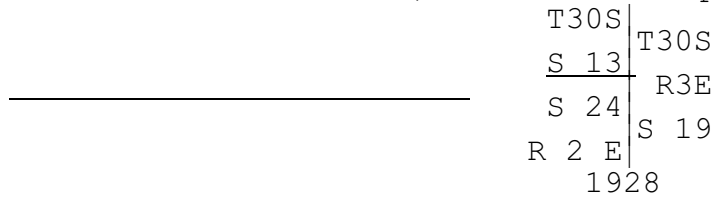

from which

A fir, 43" dia., bears S.19½°W., 79 lks., mkd: T30S R2E S24 BT.

A fir, 34" dia., bears N.66°W., 96 lks., mkd: T30S R2E S13 BT.

The (1923) corner, by Mensch & Wilkes (Vol. 26 Pg 11141), established for secs. 13, 18, 19, & 24, on line (S.0°13'W., 5.7 chs and West 24 lks.). We obliterate this corner.

H Raymond fd that there was an error in the 1923 survey by Mensch & Wilkes (see note pg 11026-7) - DCSO, JC 6/6/2012