

Alias _____ Description _____
 Alias _____ Description _____
 Alias _____ Description _____
 Alias _____ Description _____

GLO survey by W.H. Byars, Deputy Surveyor under contract # 450 dated July 28, 1882 (DCSO records Vol. 17 Page(s) 7253-54)

 Set a stone 24 x 10 x 8 ins., 12" in the ground for the cor. to secs. 1, 6, 7 and 12. Marked with five notches on the S. and one notch on the N. and from which


- A Cedar 24" dia., bears N.64°E., 52 lks. dist. mkd. T30S R7W S6 BT.
- A Cedar 36" dia., bears S.46°E., 25 lks. dist. mkd. T30S R7W S7 BT.
- A Pine 15" dia., bears S.24°W., 55 lks. dist. mkd. T30S R8W S12 BT.
- A Cedar 17" dia., bears N.11°W., 50 lks. dist. mkd. T30S R8W S1 BT.

Douglas Co. Surveyors Office - James W. Byron, Deputy - Mike Darby; Jim Halterman, crew - Feb. 1964 - C.S. File 53/40-39

 Found - Orig. 15" Pine S.24°E., 36.3 ft., shows good scribing.
 Orig. 24" now 32" Cedar N.64°E., 34.3 ft., shows good scribing.
 NW. Bt, now remains of stump.
 SE. BT, now down.

Corner is at foot of 10 ft. high bluff.

Set Brass cap at cor. mkd: County Surveyors Office

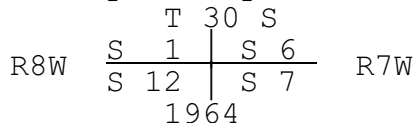

New BTs -8" R.Fir bears S.26°E., 66.0 ft. scribed S7 T30S R7W CS BT.

14" R.Fir bears N.72°W., 55.6 ft. scribed S1 T30S R8W CS BT.

BLM Resurvey by Wayne L. Rogers; Dale T. Bedell; Boyd W. Peterson; - Under Group #1456, Surveyed Sept. 1988/Feb. 1989 (DCSO records Vol. 50 Page(s) 19037)

 The cor. of secs. 1, 6, 7 and 12 perpetuated and recorded by Byron, Deputy County Surveyor, in 1964, monumented with an iron post, 1¼ ins. diam., firmly set, projecting 12 ins. above ground, with 1964 brass cap.

from which the remains of the original bearing trees
 A cedar snag, 26 ins. diam., bears N. 64° E., 52 lks. dist., with illegible scribe marks visible on partially healed blaze. (Cont. Next Page)

Alias _____ Description _____
Alias _____ Description _____
Alias _____ Description _____
Alias _____ Description _____

A root hole, bears S. 46° E., 25 lks. dist., with a down cedar alongside, 40 ins. diam., with scribe marks T30S R W visible on partially healed blaze.
A pine stump, 42 ins. diam., bears S. 24° W., 55 lks. dist., with healed blaze.
A rotted cedar stump, 16 ins. diam., bears N. 11° W., 50 lks. dist., no visible marks.
and bearing tree mkd. by Byron
A fir, 11 ins. diam., bear S. 26° E., 100 lks. dist., with healed blaze.
A fir, 20 ins. diam., bears N. 72° W., 83 lks. dist., with healed blaze.
and new bearing trees
A fir, 39 ins. diam., bears N. 60° E., 58 lks. dist., mkd. T30S R7W S6 BT.
A fir, 7 ins. diam., bears S. 60° W., 17½ lks. dist., mkd. T30S R8W S12 BT.
The corner is at the foot of a rock outcrop, 10 ft. high facing SW.

Mark Smalley - For: Roseburg Resources - 10/06/2006 - C.S. File 65/58-22

Condition Report only
Found - 1964 DCSO IPBC (properly mkd.)
26" Cedar N.64°E., 34.3 lying by corner mon. (Orig)
42" Pine stump S.24°W., 36.3 gone. (Orig.)
40" Cedar S.46°E., 16.5 down
16" Cedar stump N.11°W., 33.0 gone.
13" Fir S.28°E., 66.0 good condition - healed face (Rec. S.26°E.)
12" W.Fir S.60°W., 11.6 good condition - healed face
24" W.Fir N.72°W., 54.8 good condition - healed face (Rec. 55.6')
36" Fir N.79°W., 38.0 "X" scribed in bark - 1958 tag
38" Fir N.60°E., 38.3 good condition - healed face.