

PRIMARY CORNER DESCRIPTION AM Cor. (Was cor. secs. 1, 6, 7, & 12)


Alias \_\_\_\_\_ Description \_\_\_\_\_  
 Alias \_\_\_\_\_ Description \_\_\_\_\_  
 Alias \_\_\_\_\_ Description \_\_\_\_\_  
 Alias \_\_\_\_\_ Description \_\_\_\_\_

Wm. P. Wright, Deputy Surveyor, under Contract #281 dated May 16, 1878, surveyed, June 27, 1878. - Resurvey of north 2 miles of the west boundary, T31S R5W. (DCSO records Vol. 33 Pg. 13666)

-----  
 Search for a post or evidence of bearing trees and find none. Am certain that I am on the old line for the last 20 chains, my blazes have been on the same trees marked by former surveyor.  
 Set a post 6" x 6" by 5 ft. long, 20" in ground in mound of stone, from which:  
     A Fir, 12" dia. bears **North** 10 lks.  
     A V.Maple, 8" dia. bears N.84°W., 40 lks.  
     A Fir. 14" dia. bears S.78°W., 12 lks.  
     A Fir, 16" dia. bears S.4°E., 18 lks.

Douglas Co. Surveyors Office - John M. Powell, Frank Jones & C.Stone. October 3, 1966 - C.S. File 54/31.

-----  
 Found - 16" D.Fir, now 36", S.4°E., 11.9 ft. Had been opened & burned open more, but no scribing visible.  
         14" Fir, now down, S.78°W., 7.9 ft. Old rotten snag has axed face with faint "S" & other marks. Scribing done with very fine scribe or knife.  
         12" Fir, now down snag, **North** 6.6 ft. has old axe work, no scribe.  
         No trace of 8" V.Maple.  
 By ring count on 36" Fir it places this corner at "1878". Also call on small creek, 16.5 ft. N. of cor. hits very good.  
 Set - Brass Cap at corner marked: COUNTY SURVEYORS OFFICE

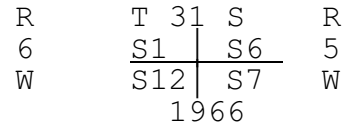

New BTs- 14" Maple, N.8°E. 31.0 ft. mkd."T31S R5W S6 CS BT"  
         12" Maple, N.58°W. 48.3 ft mkd."T31S R6W S1 CS BT"  
         13" Maple, S.84°W. 36.0 ft mkd."T31S R6W S12 CS BT"  
 Reblaze & rescribe: 36" D.Fir, S.4°E., 11.9 ft.  
         mkd. "T31S R5W S7 CS BT"

Douglas Co. Surveyors Office - Larry Monrean, P.L.Earle, F.C.Silagy. - June 28, 1978, C.S. File 60/11-24

-----  
 Found - 1" I.P. with 1966 County Brass cap properly marked. Monument is approx. one foot high and approx. 16½ ft. south of a creek, course east.  
 continued next page

TOWNSHIP 31 RANGE 05 POINT IDENTIFIER # 101600

PRIMARY CORNER DESCRIPTION AM Cor. (Was cor. secs. 1, 6, 7, & 12)

Alias	_____	Description	_____
Alias	_____	Description	_____
Alias	_____	Description	_____
Alias	_____	Description	_____

- 16" Fir, now 32" bears S.1°W. (rec. S.4°E.) 13.1 ft. to center, 12.3 ft. to face. (rec. 11.9 ft.). Tree has partially healed double blaze "BT" visible.
- 12" Fir, now a 16" snag tipped out bears **North** 6.6 ft.
- 14" Fir stump, now dislodged bears N.78°W., 7.9 ft. to root hole. Find old axe marks, no scribing.
- 14" Maple, now 15" bears N.8°E., 31.0 ft. to center of scribed trunk, 31.5 ft. to center of triple forked base. Scribed "S5" on a partially healed double blaze.
- 12" Maple now N.55½°W (Rec. N.58°W) 48.3', scribing visible on a partially healed single blaze.
- 13" Maple now 16" bears S.85°W. (rec. S.84°W.) 36.0 ft. Scribing visible on single blaze.

No new monument or accessories.

BLM dependent resurvey by Daniel E. Weller, Cadastral Surveyor, under Group #1884, surveyed July/Sept 1998. (DCSO records Vol. 53 Page(s) 20482-3)

-----  
The cor. of secs. 1, 6, 7, and 12, established by Wright, perpetuated by Powell, in 1966, and further recovered by Monrean, in 1978, monumented with an iron pipe, 1¼"dia., loosely set, projecting 10" above a mound of stone, 2½ ft. base, 2 ft. high, with brass cap mkd. COUNTY SURVEYORS OFFICE T31S R6W S1 S6 R5W S12 S7 1966, from which the remains of the original Wright bearing trees:

- A root hole, bears North, 10 lks.
  - A fir, 31" dia., bears S.4°E., 18 lks., with no marks visible on opened blaze.
  - A root hole, bears S.78°W., 12 lks.
- and bearing trees mkd. by Powell
- A maple, 14" dia., bears N.8°E., 45½ lks., with a healed blaze.
  - A maple, 16" dia., bears S.84°W., 54½ lks., with a healed blaze.
  - A maple, 14" dia., bears N.58°W., 73 lks., with a healed blaze.

**Remark the brass cap to read AM 16.60 FT TO COR 1998 and an arrow pointing to the corner.**