


1" = 2000'

- BLM RESURVEYS ----- \\\\\\\\\\\\\\\
- CORNERS RENEWED OR ESTABLISHED ----- ●
- CORNERS FOUND AND USED ----- □
- CORNERS LOOKED FOR AND NOT FOUND ----- ○
- COUNTY BOUNDARY ----- . . . . .
- CORNER RENEWED - LAST REPORT NOT FD ----- \*

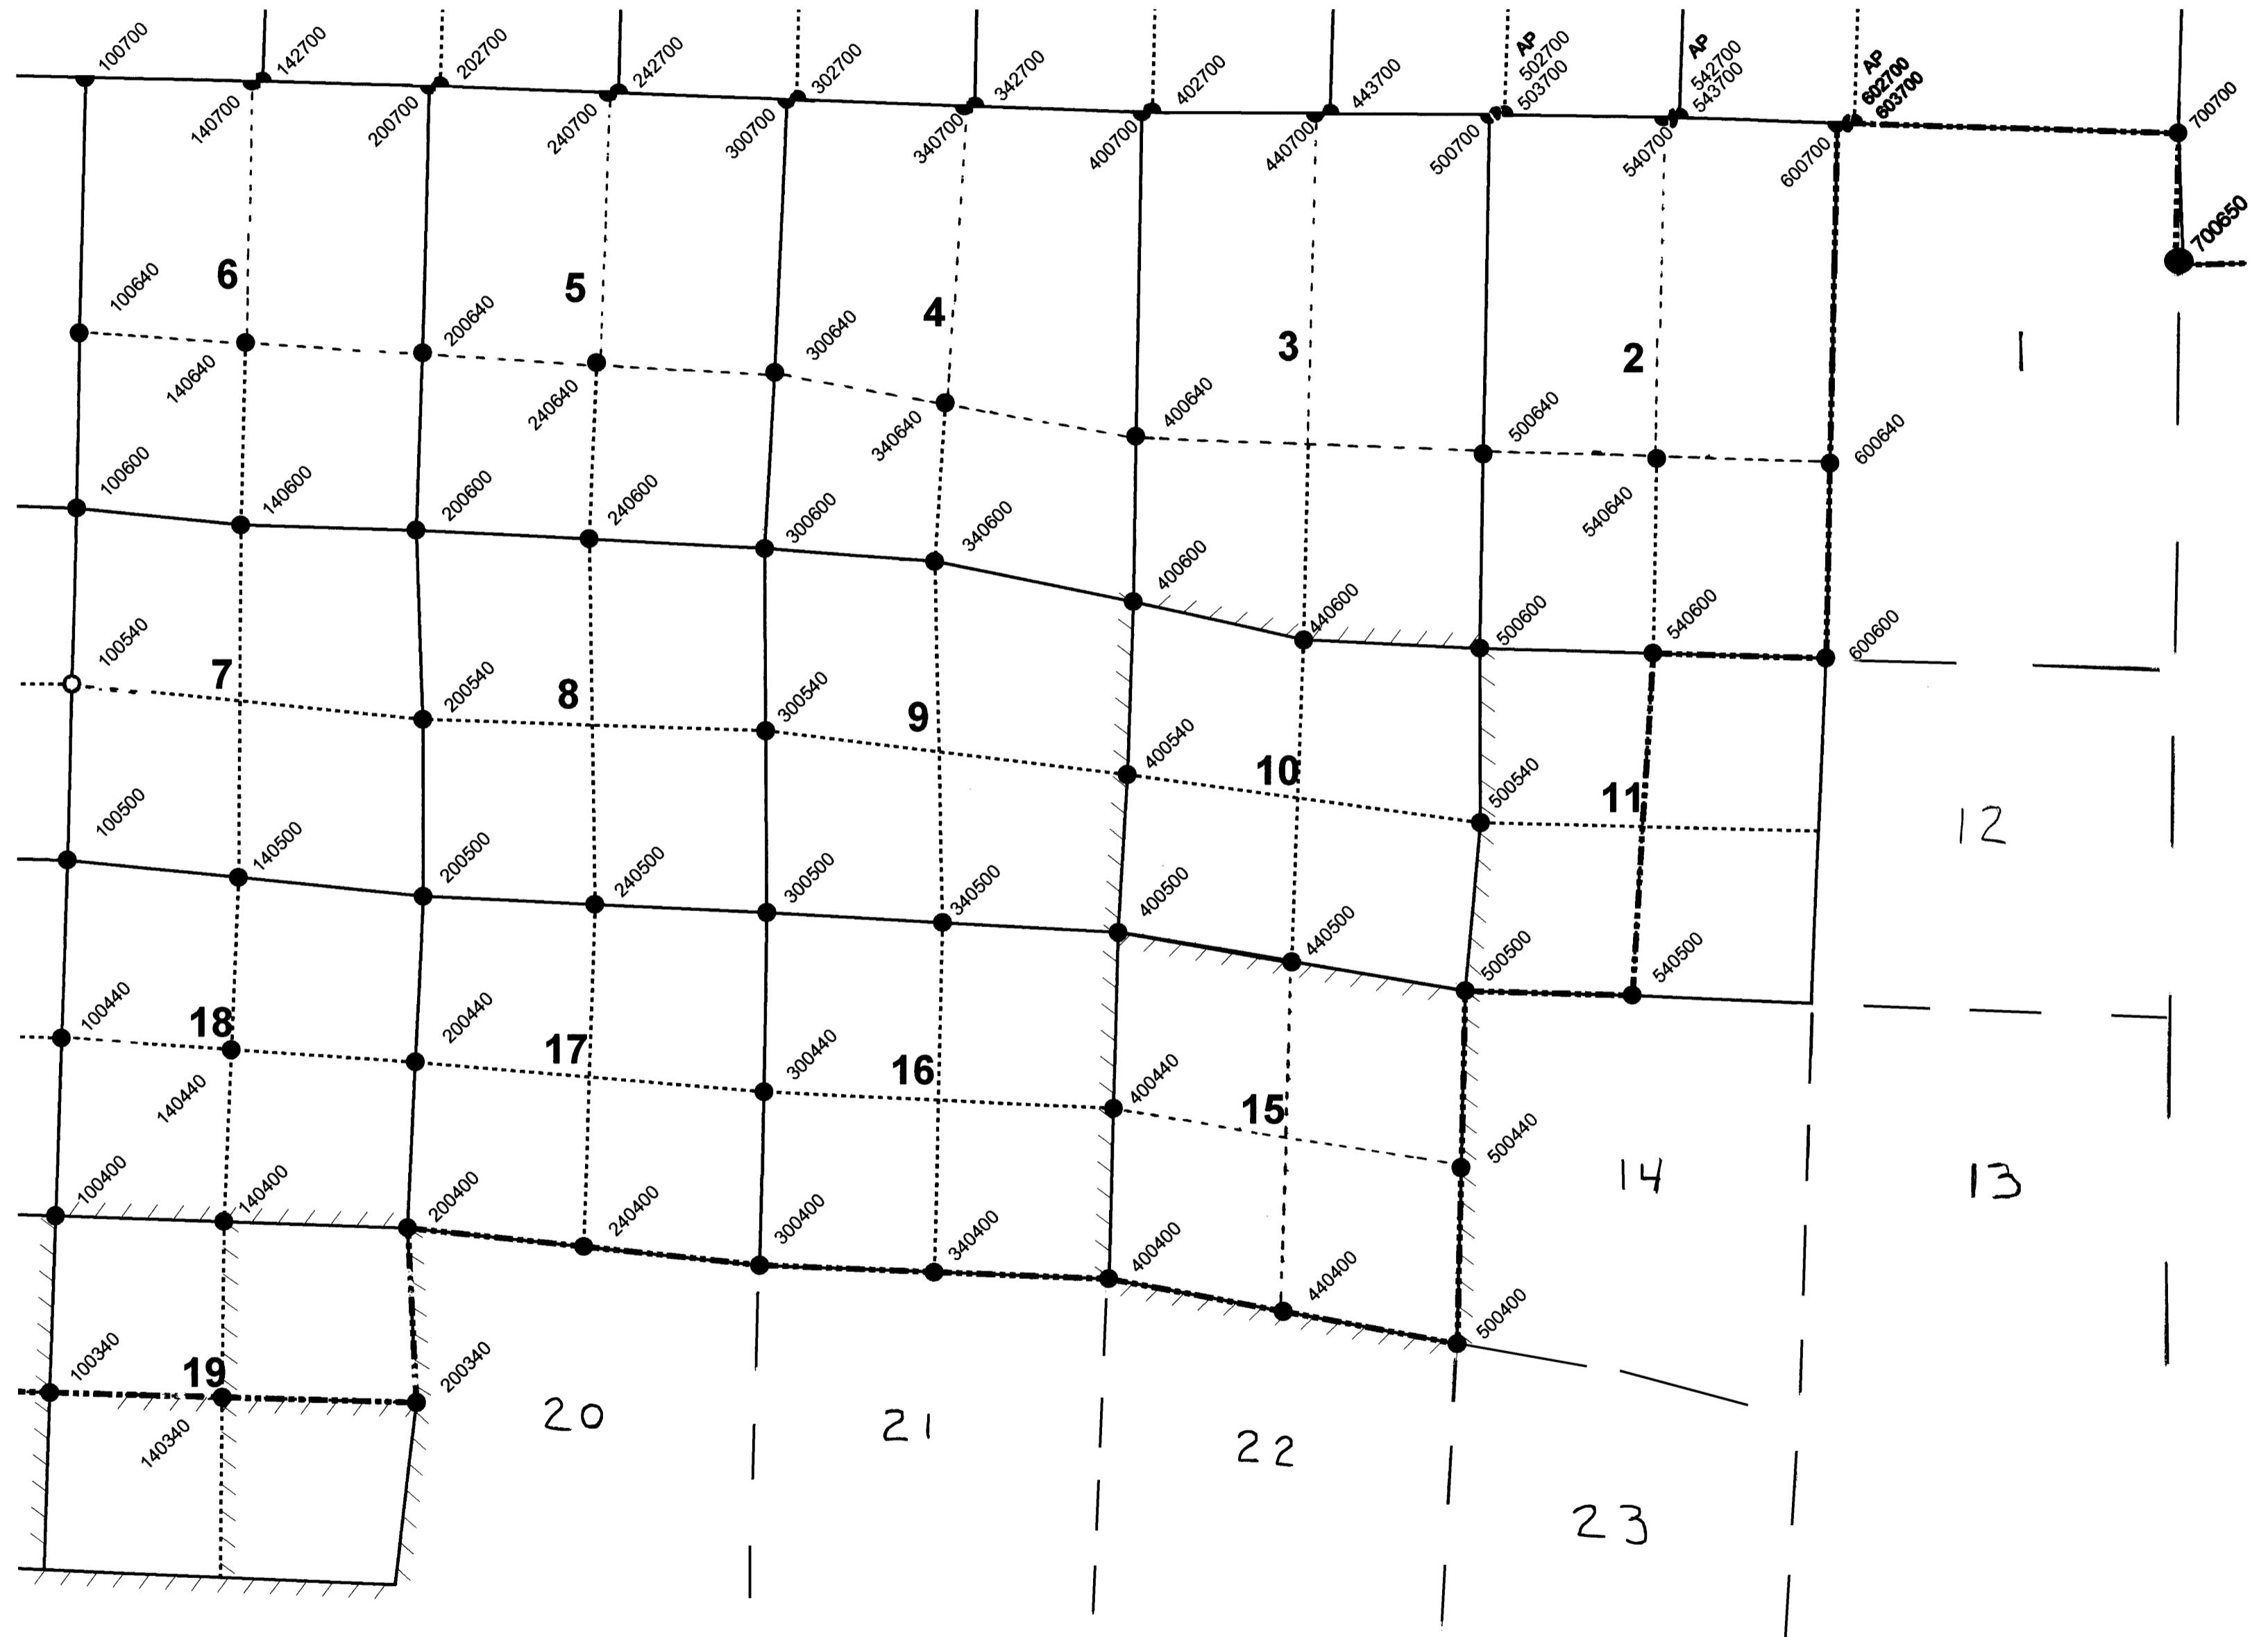

JACKSON COUNTY