


# T 32 S R 5 W

1" = 2000'

- B. L. M. RESURVEYS - - - - -
- CORNERS RENEWED OR ESTABLISHED - - - - - ●
- CORNERS FOUND AND USED - - - - - ■
- CORNERS LOOKED FOR AND NOT FOUND - - - - - ○
- CORNER RENEWED - LAST REPORT NOT FD - - \*

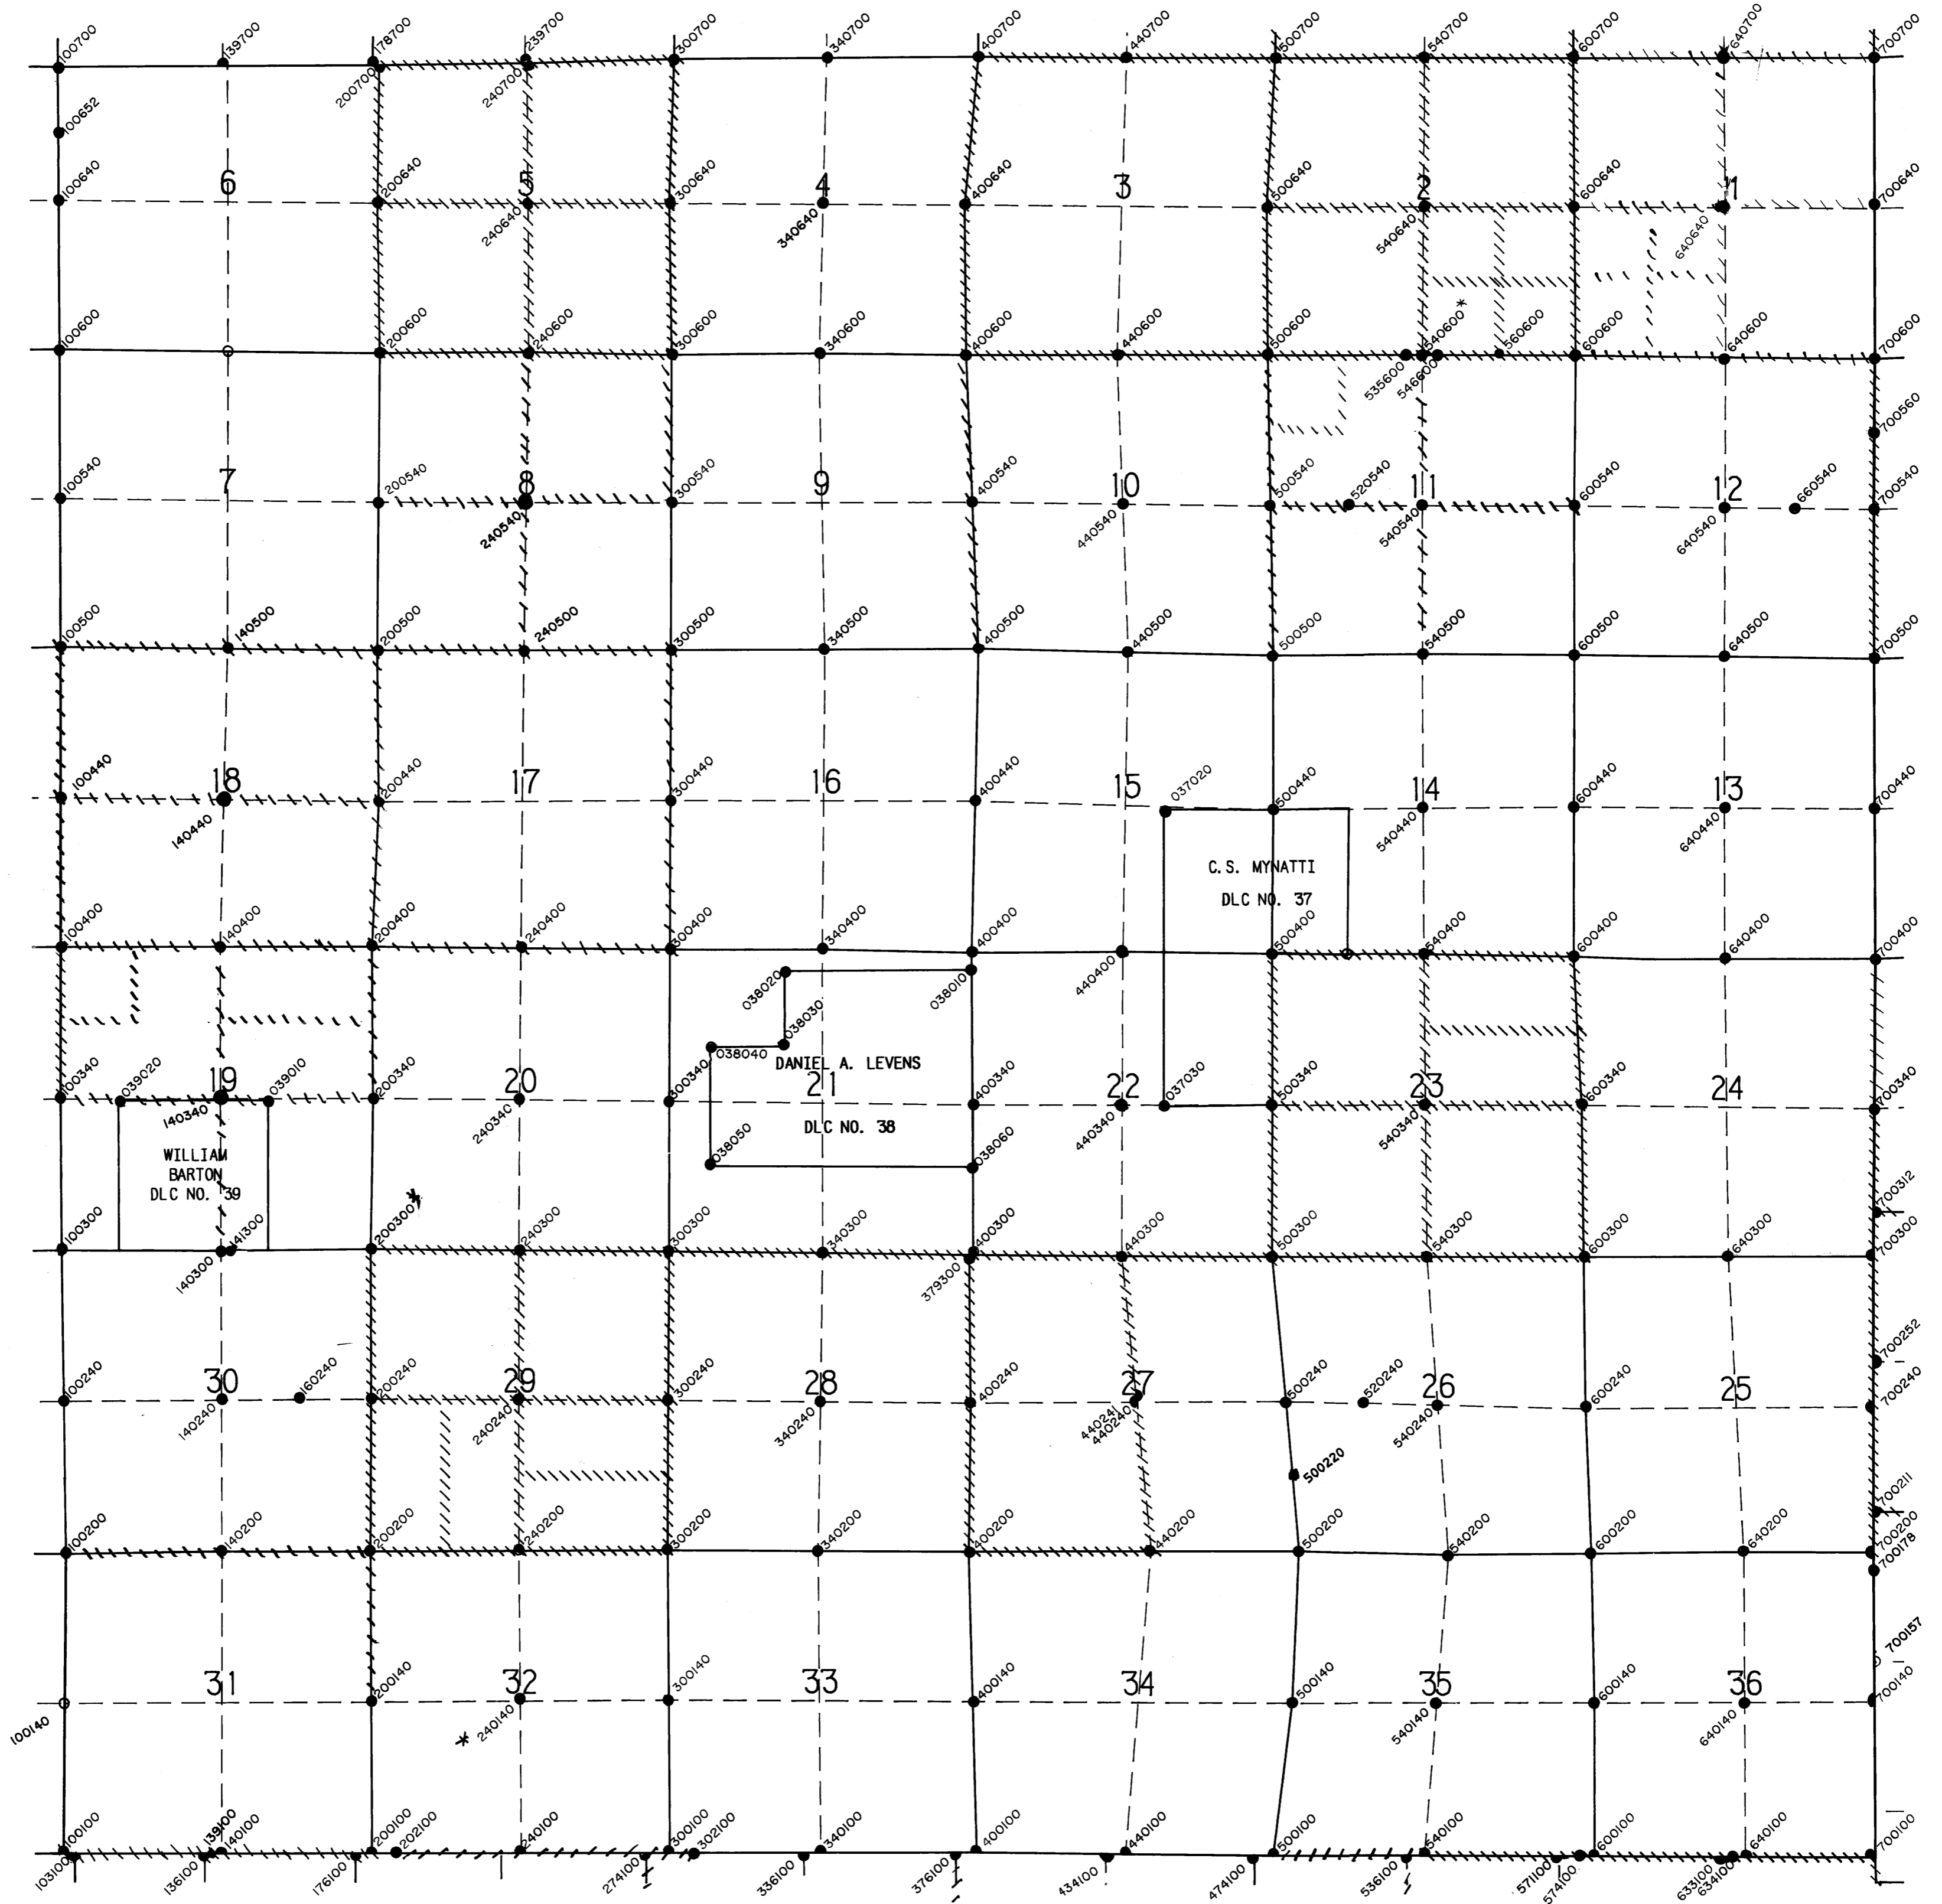


# SPECIAL INSTRUCTIONS DIAGRAM

## TOWNSHIP 32 SOUTH, RANGE 5 WEST, WILLAMETTE MERIDIAN

GROUP No. 3043 OREGON  
SHEET 2 of 2

Sec. 14

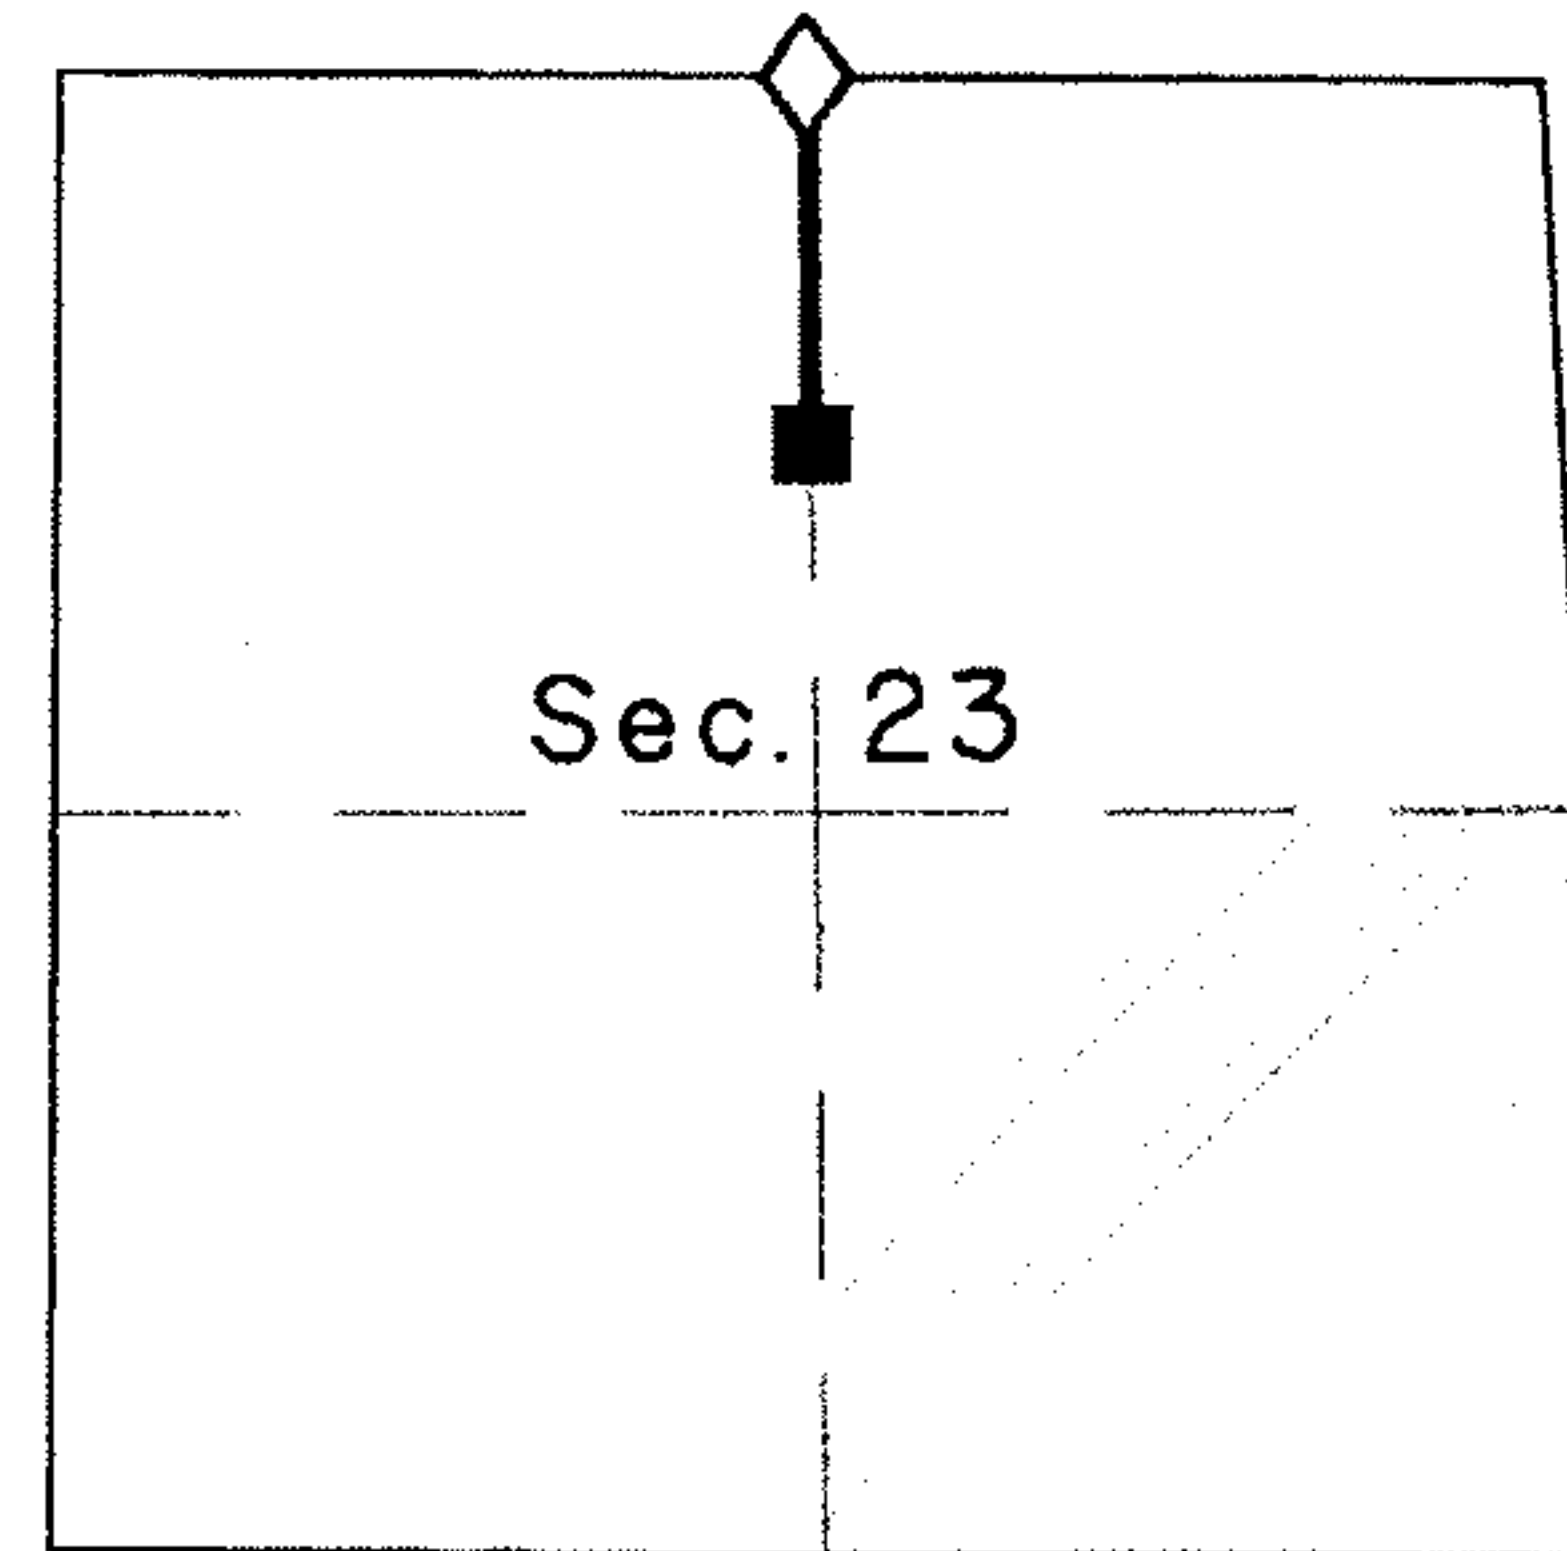


Sec. 28


Sec. 27

Sec. 26

Sec. 25

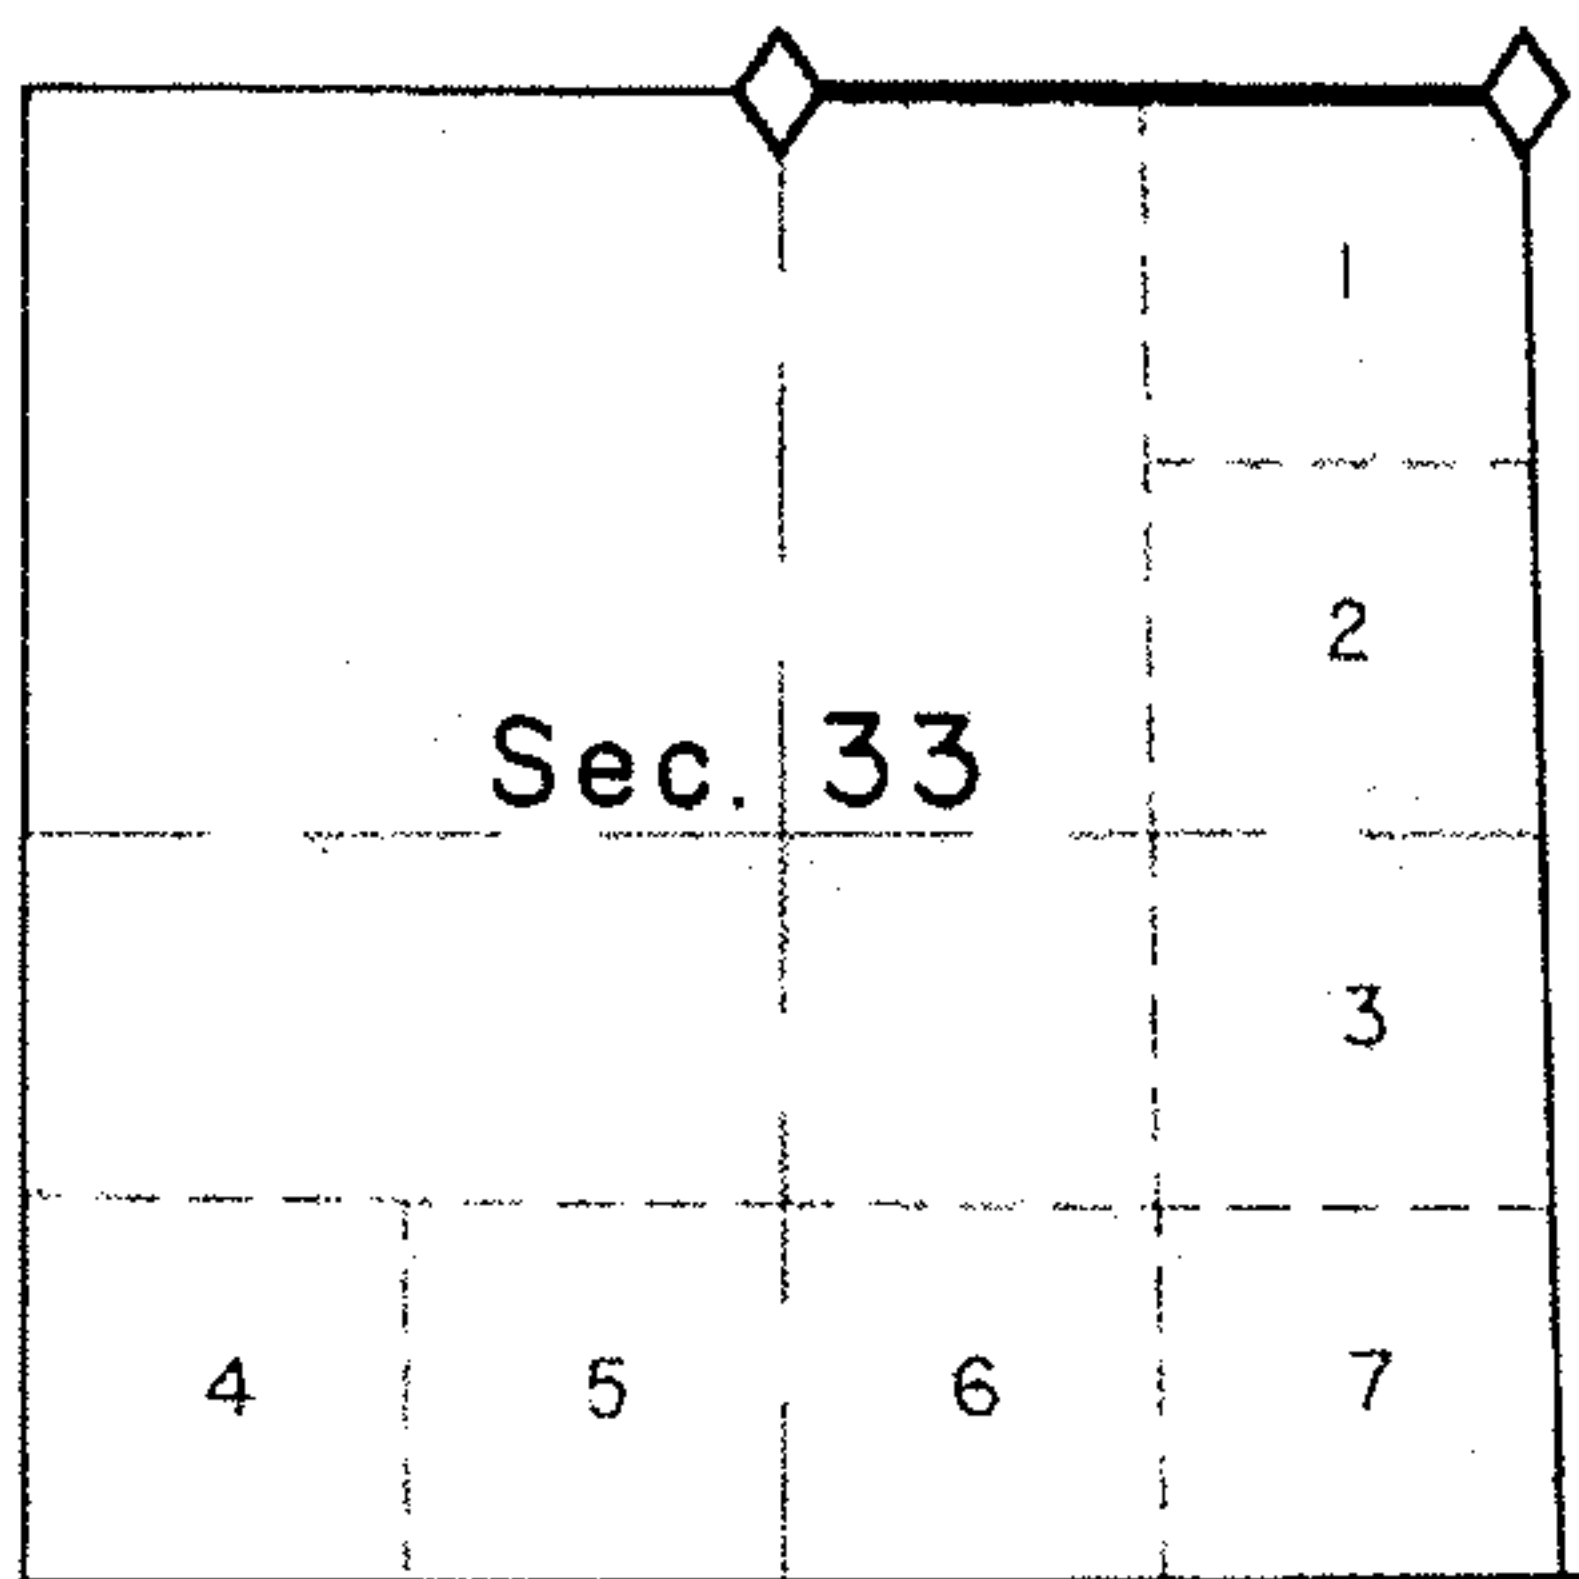

Sec. 34

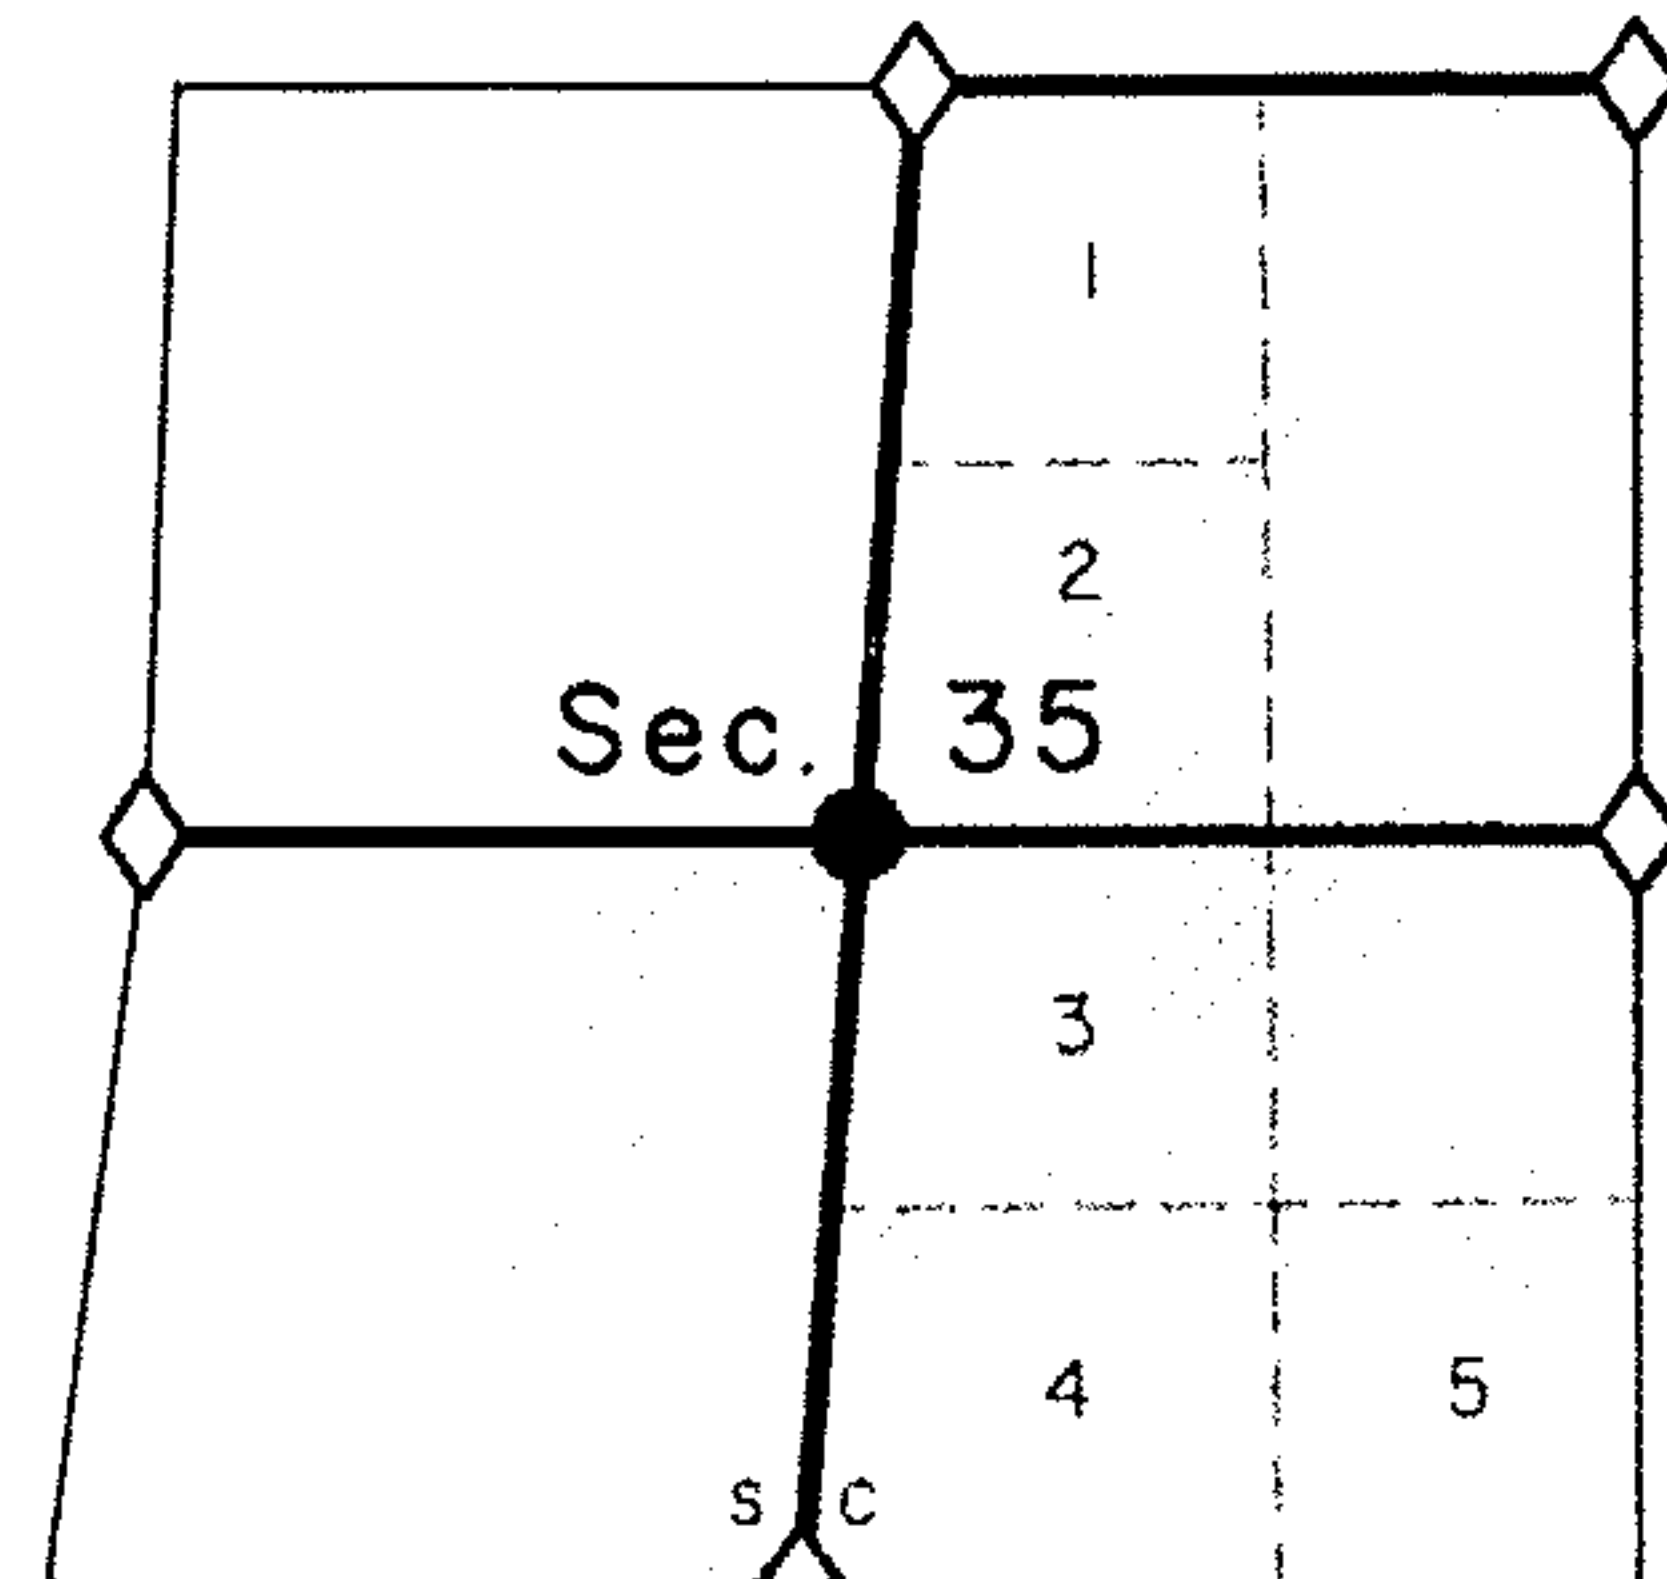


Sec. 36

T. 32 S.  
T. 33 S.

T. 32 S.  
T. 33 S.

Sec. 2

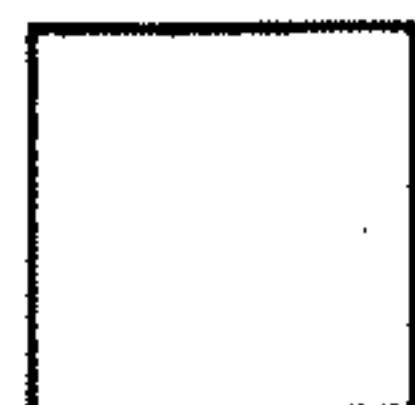

Public Land  
Administered  
by BLM

- ◊ Corner to be recovered or reestablished
- Corner previously established or reestablished
- Corner to be established
- Line to be surveyed or resurveyed

*1004*