

TOWNSHIP 32 RANGE 05 POINT IDENTIFIER # 100400

PRIMARY CORNER DESCRIPTION Sec Cor for 18 & 19; 13 & 24, T32-6

Alias _____ Description _____
Alias _____ Description _____
Alias _____ Description _____
Alias _____ Description _____

Original - George W. Hyde and Wells Lake, under Contract #54 dated Feb. 19, 1855 (DCSO records Vol. 20 Page(s) 8554)

Set post cor. to secs. 13, 18, 19 and 24, from which
A Maple 10" dia., bears S.19°E., 44 lks.
A Maple 12" dia., bears N.73°W., 76 lks.
A Laurel 11" dia., bears S.26°W., 27 lks.
A Fir 32" dia., bears N.33°E., 30 lks.

GLO survey by Oscar F. Thiel, Deputy Surveyor, under Contract #729, dated Dec. 24, 1900 and special instructions dated Sept. 21, 1901 (DCSO records Vol. 20 Page(s) 8622)

The Sec. Cor., which having disappeared, I replace by setting a Cedar post, 3 ft. long, 4" sq. 24" in the ground for cor. of secs. 13, 18, 19 and 24, marked T32S S18 on NE.; R5W S19 on SE.; S24 on SW.; and R6W S13 on NW. faces, with 3 notches on S. and N. edges, from which
A W.Fir 5" dia., bears S.39°W., 31 lks. dist. mkd. T32S R6W S24 BT.
The three other bearing trees are the same, as described by the surveyor general.

G.J. Wenderoth, Surveyor (Record source not found. Information from "old" renewal #6 in T32-6)

Set 3/4" Iron pipe.
36" Cedar bears S.11°22'W., 44.2 ft.
16" Cedar bears N.69°15'E., 54.9 ft.

Douglas Co. Surveyors Office - John M. Powell, Frank Jones, Joe Brady, crew - August 1967 - C.S. File 53/52-9

Found - 3/4" Iron pipe.
Orig. 32" D.Fir now stob, N.33°E., 19.8 ft., shows scribing.
14" Cedar N.68½°E., 55.2 ft. scribed S18 with good face.
34" Cedar S.12°W., 44.8 ft. scribed S24 with good BT face.

Set Brass cap at cor. mkd: County Surveyors Office

	T	32	S	
R	S	13	S	18
6	S	24	S	19
W		1967		W

New BTs -6" D.Fir N.27°W., 7.0 ft. mkd. T32S R6W S13 CS BT.
6" Maple S.34°W., 33.6 ft. mkd. T32S R6W S24 CS BT.
6" W.Fir S.11°E., 25.4 ft. mkd. T32S R5W S19 CS BT.


(Cont. Next Page)

Alias _____ Description _____
 Alias _____ Description _____
 Alias _____ Description _____
 Alias _____ Description _____

B.L.M Dependent resurvey by Francis Simon, Aug.-Sept. 1992
 (DCSO records Vol. 51 Page 19576)

 Found - iron post, 1 in. diam., firmly set, projecting 12
 ins. above the ground, with brass cap mkd.

COUNTY SURVEYORS OFFICE
 T32S

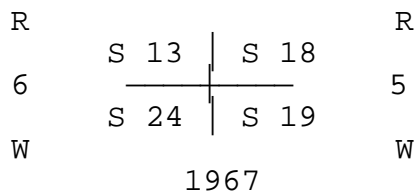

1967

Bearing trees mkd. by Wenderoth

A sawed cedar stump, 18 ins. diam., bears N. 68½° E.,
 83½ lks. dist., no marks visible.

A cedar snag, 37 ins. diam., bears S. 8 3/4° W., 68
 lks. dist., with scribe marks S24 visible on
 partially healed blaze.

Bearing trees mkd. by the County Surveyor's Office

A white fir, 11 ins. diam., bears S. 11° E., 37½ lks.
 dist., with healed blaze.

A maple, 10 ins. diam., bears S. 34° W., 51 lks.
 dist., with scribe marks 32S 6 2 visible on
 partially healed blaze.

A fir, 18 ins. diam., bears N. 27° W., 10 lks. dist.,
 with healed blaze.

New bearing tree

A white fir, 12 ins. diam., bears N. 44¼° E., 69½ lks.
 dist., mkd. T32S R5W S18 BT.

Lloyd Smith - For: Oregon Department of Forestry - March 1997
 - M 124-46

 Found - DCSO pipe & cap alongside 3/4" IP
 36" Cedar S.11°22'W., 44.2' (Now 38" windfall face
 chopped out scribes visible)
 16" Cedar N.69°15'E., 54.9' (12"x1' high, badly
 rotted stump in place)
 6" D.Fir N.27°W., 7.0' (Now 19" in place face closed
 bearing tree tag)
 6" Maple S.34°W., 33.6' (Now down & knocked over by
 windfall)
 6" W.Fir, S.11°E., 25.4' (Now 12" in place, face
 closed, bearing tree tag)
 12" W.Fir, (1992) N.44¼°E., 69½ lks (now 14" in
 place, scribed visible)

cont. next pg

TOWNSHIP 32 RANGE 05 POINT IDENTIFIER # 100400

PRIMARY CORNER DESCRIPTION Sec Cor for 18, 19; 13, 24 T32-6

Alias _____ Description _____
Alias _____ Description _____
Alias _____ Description _____
Alias _____ Description _____

BLM Dependent resurvey by Arthur R. Rambo, & Francis Simon
Cadastral Surveyors under Group No. 2143, surveyed May
2006/Feb. 2007 - (DCSO records, Vol. 55 Page(s) 21671)

The cor. of secs. 13, 18, 19, & 24, on the W. bdy. of the Tp,
monumented with an iron post, 1" dia., firmly set, projecting
12" above the ground, with brass cap (properly) mkd.
from which the remains of a bearing tree mkd. by Wenderoth,
reported by Simon in 1992

A stump hole bears S.8¾°W., 44.9 ft. with a sawed cedar
stump, 37" dia., alongside, with no visible marks.
and remains of bearing trees mkd. by the Douglas County
Surveyor's Office, reported by Simon in 1992

A fir snag, 11" dia., bears S.11°E., 24.8 ft., with a
healed blaze.

A fir, 24" dia., bears N.24½°W., 7.5 ft., with a healed
blaze. (Record, N.27°W., 6.6 ft.)
and a bearing tree mkd. by Simon in 1992

A fir, 18" dia., bears N.44¼°E., 45.9 ft., with a healed
blaze.
and new bearing trees

A fir, 13" dia., bears S.88½°E., 23.1 ft., mkd. T32S R5W
S19 BT.

A maple, 20" dia., bears S.40¼°W., 50.1 ft., mkd. T32S R6W
S24 BT.

Each new bearing tree has a 2½"x ¼" magnetic nail (Mag Nail)
driven at the base right side-center, unless otherwise
described in the corner description

(NAD 1983 (CORS 96))

Latitude: 42°47'51.77" N. Longitude: 123°20'52.22" W.