

TOWNSHIP 32 RANGE 06 POINT IDENTIFIER # 100500

PRIMARY CORNER DESCRIPTION Sec. cor. for 7 & 18; 12 & 13, T32-7

Alias _____ Description _____
Alias _____ Description _____
Alias _____ Description _____
Alias _____ Description _____

GL0 survey by George W. Hyde and Charles H. Gardner, Deputy Surveyors, under Contract #54, dated Feb. 19, 1855 (DCSO records Vol. 20 Page(s) 8633)

Set post, cor. to secs. 17, 12, 13 and 18, on N. slope, from which

- A Fir 16" dia., bears S.74°E., 53 lks. dist.
- A Laurel 12" dia., bears N.41°E., 61 lks. dist.
- A Laurel 12" dia., bears N.17°W., 105 lks. dist.
- A Laurel 6" dia., bears S.65°W., 80 lks. dist.

GL0 survey by W.H. Byars, under contract # 420 survey dated Sept. 16 1861 (DCSO records Vol. 20 Page(s) 8660-61)

Set a Cedar post for the cor. secs. 7, 12, 13 and 18, viz: 4½ ft. long, 4" sq., 22" in ground and mkd. T32S R6W S7 on SE. face; S18 on SE. face; S13 on SW. face; T32S R7W S12 on NW. face. Also 4 notches on S. and 2 on both angles of same, from which

- A Fir 44" dia., bears N.10°E., 31 lks. dist. mkd. T32S R6W S6 BT.
- A Fir 24" dia., bears S.8°E., 18 lks. dist., mkd. T32S R6W S18 BT.
- A Fir 10" dia., bears S.12°W., 31 lks. dist. mkd. T32S R7W S13 BT.
- A Fir 15" dia., bears N.63°W., 71 lks. dist. mkd. T32S R7W S12 BT.

Douglas Co. Surveyors Office - John M. Powell, Joe Brady, crew - Sept. 24, 1965 - C.S. File 49/91-15

Found - 15" D.Fir now 24", N.63°W., 47.0 ft., faint bark scribe. Good tree.

24" D.Fir now 40", S.8°E., 11.9 ft., good bark scribe, "R6 S18". Tree is windfall.

No trace of other trees.


New BTs -6" D.Fir S.76°W., 55.6 ft. scribed S13 CS BT.

24" D.Fir N.63°W., 47.0 ft. scribed T32S R7W S12 CS BT.

30" D.Fir S.85°E., 38.8 ft. scribed T32S R6W S18 CS BT.

16" D.Fir N.72°E. 91.6 ft. scribed T32S R6W S7 CS BT

Set brass cap at cor. mkd: County Surveyors Office

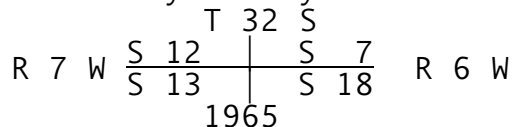

TOWNSHIP 32 RANGE 06 POINT IDENTIFIER # 100500

PRIMARY CORNER DESCRIPTION Sec. Cor. for 7 & 18; 12 & 13, T32-7

Alias _____	Description _____
Alias _____	Description _____
Alias _____	Description _____
Alias _____	Description _____

BLM resurvey by G. Steven Popken, Cadastral Surveyor & James J. Carlson, under Group #884. Surveyed Sept. 1975/June 1976 (DCSO records Vol. 37 Page(s) 15314-15)

The sec. cor., perpetuated and recorded by Powell in 1965, monumented with an iron pipe 1½" dia., firmly set, projecting 15" above ground with mkd. brass cap, from which the remains of the original bearing trees:

A root hole bears S.8°E., 18 lks. dist. with a down fir alongside, 40" dia., no marks visible.

A Fir 27" dia., bears N.63°W., 71 lks. dist., with healed blaze.

and the remains of bearing trees mkd. by Powell:

A Fir snag 13" dia., bears N.72°E., 141½ lks., with scribe marks T32S R6W S7 CS BT visible on open double blaze.

A Fir 31" dia., bears S.85°E., 58½ lks. dist., with healed double blaze.

A Fir 8" dia., bears S.76°W., 87½ lks. dist., with healed double blaze.

and a new bearing tree:

A Fir 50" dia., bears N.69½°E., 96 lks. dist., mkd. T32S R6W S7 BT.

Corner Fd. & used in BLM survey by Roseberry, under Group # 884, surveyed June 1979 (DCSO records, Vol. 41 Pages 16236-7)

Fd. OK, by Greg Lang, August 1988, M 106-64

Fd. & used in BLM survey by Dixon & Hartley, under Group #1337, surveyed July/Sept. 1989 (DCSO rec., Vol. 48 Pg 18562)

Carl Sweeden - June 7, 2004 - C.S. File 65/49-42

Found - 1965 2½" DCSO BC, up 1.6' leaning North in rock mound, reset vertical.

Root hole, S.8°E., 11.9' remains of rotting 40" Fir on ground.

33" D.Fir, N.63°W., 46.86', healed dbl blaze, tag.

13" D.Fir, S.85°E., 38.6', tag, scar from healed dbl blaze.

10" D.Fir, S.76°W., 56.3' (57.75') healed dbl blaze, tag.

53" D.Fir, N.69½°E., 63.36', bark scribe vis. in dbl blaze, tag.

New - Drove steel "U" post 1.0' East.
Compass decl. 19½°E.