

PRIMARY CORNER DESCRIPTION 1/4 Cor. for Secs. 7 and 8

Alias_____	Description_____
Alias_____	Description_____
Alias_____	Description_____
Alias_____	Description_____

GLO survey by Edward F. Sharp, Deputy Surveyor, under Contract #617, dated June 3, 1893 (DCSO records Vol. 21 Page(s) 8942)

-----

Set a post 3 ft. long, 3" sq., 24" in the ground for 1/4 sec. cor. marked 1/4 on W. face, from which

A Fir 10" dia., bears N.21°E., 29 lks. dist., marked 1/4 S BT.

A Fir 16" dia., bears S.72°W., 40 lks. dist., marked 1/4 S BT.

Survey by H.W. Lawrence - August 1955 - C.S. File 42/79

-----

Corner set at mid-point on line between section corners. Set a 3/4" O.D. galv. Iron pipe 36" long, set in the ground with a mound of stone 18" high surrounding the pipe, from which

A R.Fir 30" dia., bears N.34°E., 31.4 ft. bark scribed 1/4 S8 BT 1543.


A R.Fir 18" dia., bears S.29°W., 41.6 ft. scribed 1/4 S7 BT 1543.

Someone, unknown to me, placed a stake witnessed by a Fir tree marked 1/4 cor. at 15.3 ft. N. and 42 ft. W. of the corner I set. Cut brush indicates he came in from the East.

Douglas Co. Surveyors Office - John Powell, W. Penley, J. Heritage, crew - June 5, 1970 - C.S. File 54/114-7

-----

Found - 3/4" I.Pipe at corner in mound of stone.  
 30" D.Fir now stump, N.34°E., 31.4 ft. bark scribe visible, "1543".  
 18" now 20" D.Fir S.29°W., 41.6 ft. shows good scar.  
 Set Brass cap at cor. mkd: County Surveyors Office  
 T 33 S R 4 W

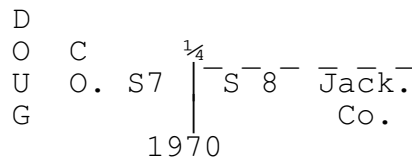

New BT - 15" W.Fir N.73°E., 3.7 ft. mkd. 1/4 S8 CS BT.

Fd. OK, H. Pieske, May 1993, M 117-13