


County Surveyor's Record, Douglas County, Oregon

TOWNSHIP 22 SOUTH, RANGE 9 WEST, W. M.

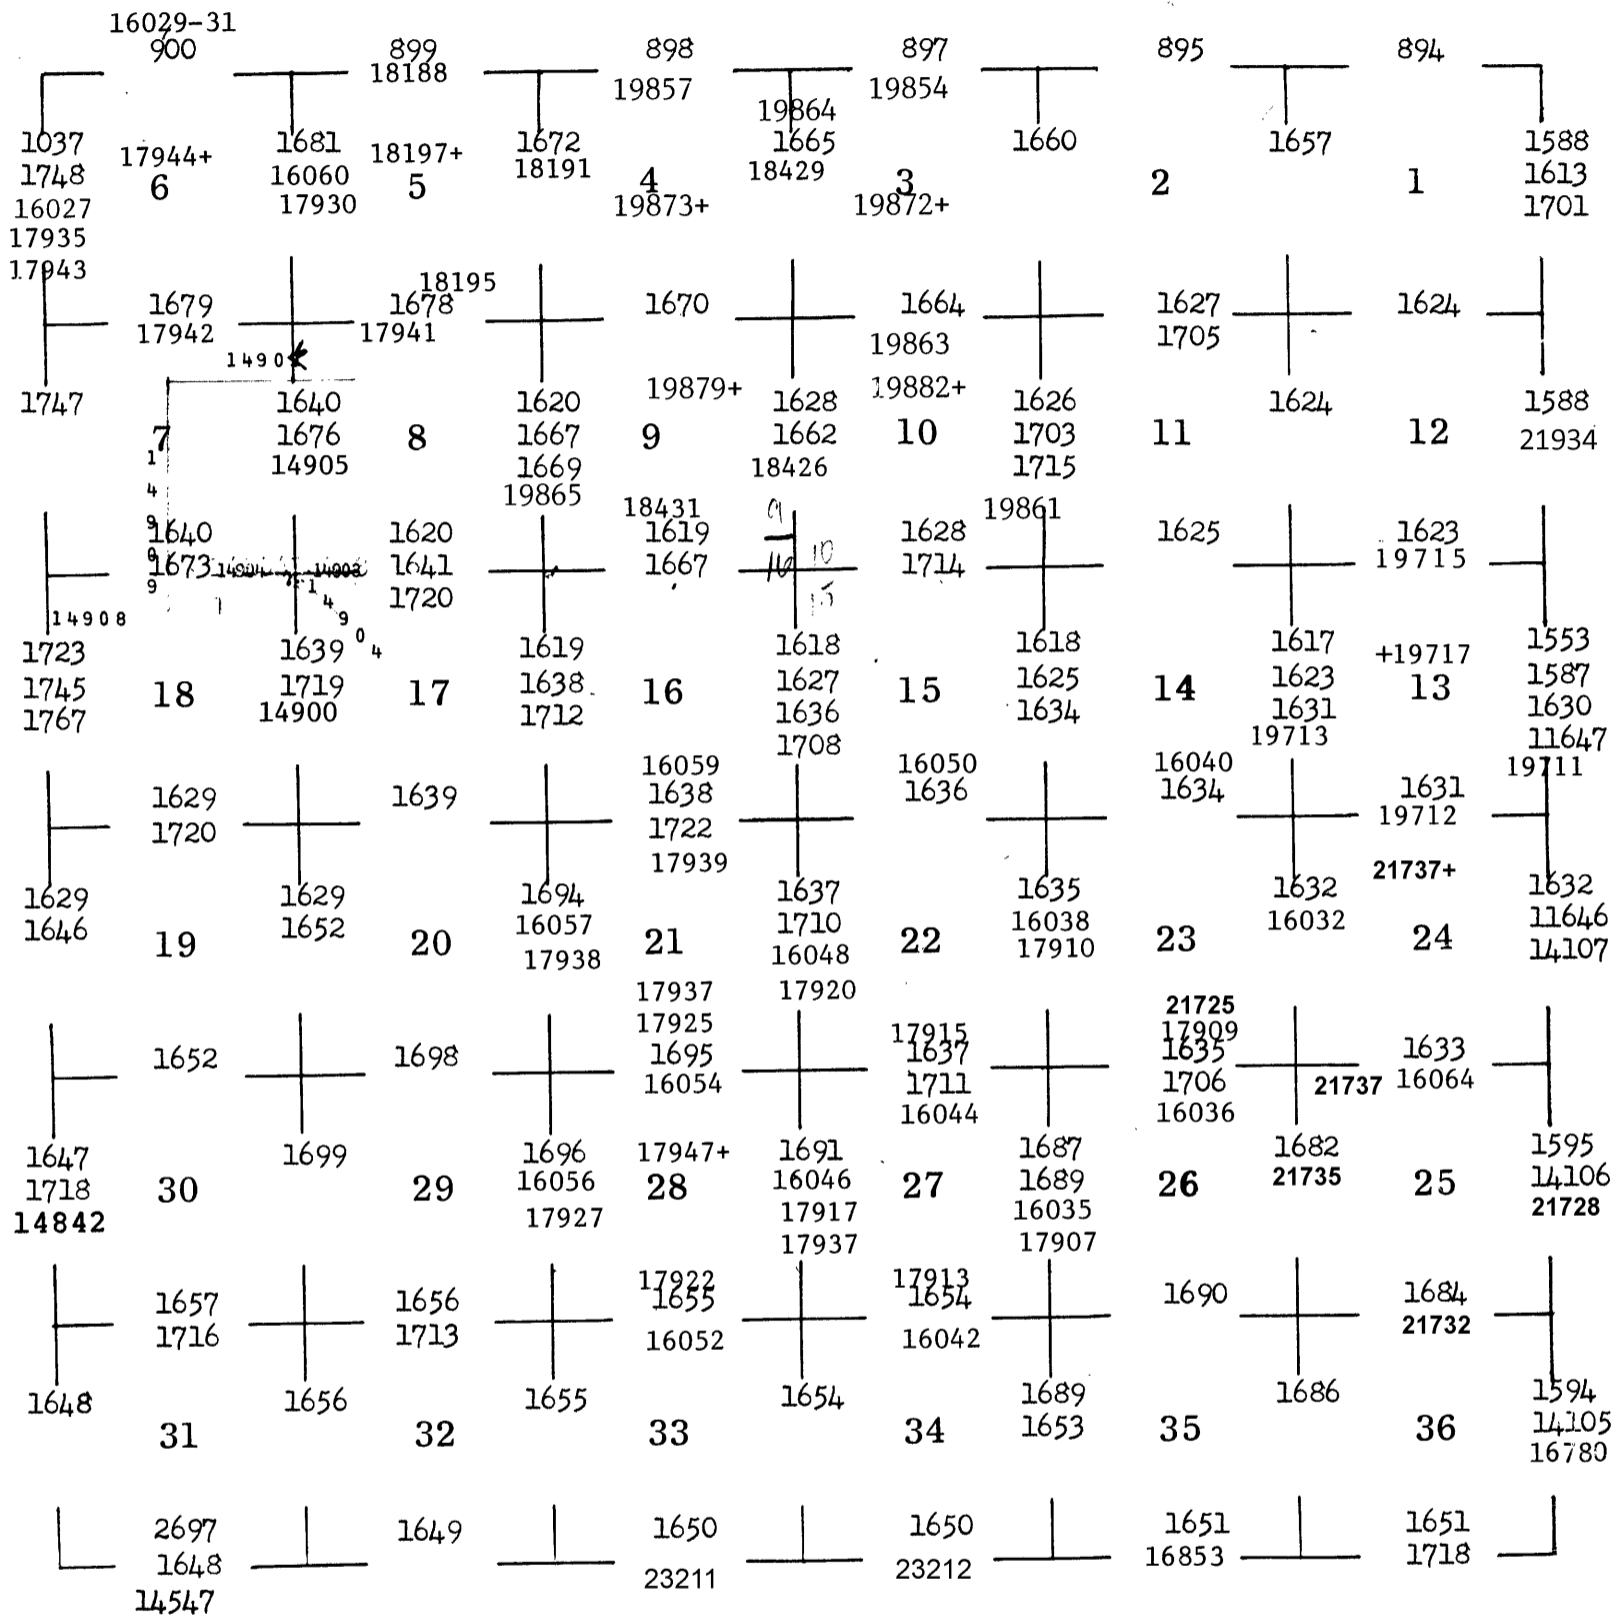

Meanders along left bank Umpqua River, Sec. 13 - Pg. 19716 (Vol. 52)

DLC Retracements

DLC #38 Vol. 36 Pg. 14904+

Portion of: DLC #45 Vol. 56 Pages 21947+

DLC #39 (N. Bdy.) Vol. 48 Pg. 18195-6

DLC #39 (E. Bdy) Vol. 52 Pg. 19869-71

DLC #40 (Portion of North Bdy) Vol. 52 Pg. 19871 - 2

~~★ NOTE - DEPENDENT RESURVEY, APPROVED FEB. 25, 1980,
IS SUSPENDED PER BLM JAN. 27, 1983 - FILE 96221 (OR 742)
SUSPENSION LIFTED 4/27/86~~

(PLAT # 5714)
R.E. Secs 6, 21, 22, 23, 27 & 28