



County Surveyor's Record, Douglas County, Oregon

TOWNSHIP 27½ SOUTH, RANGE 8 WEST, W. M.

T27S R8W

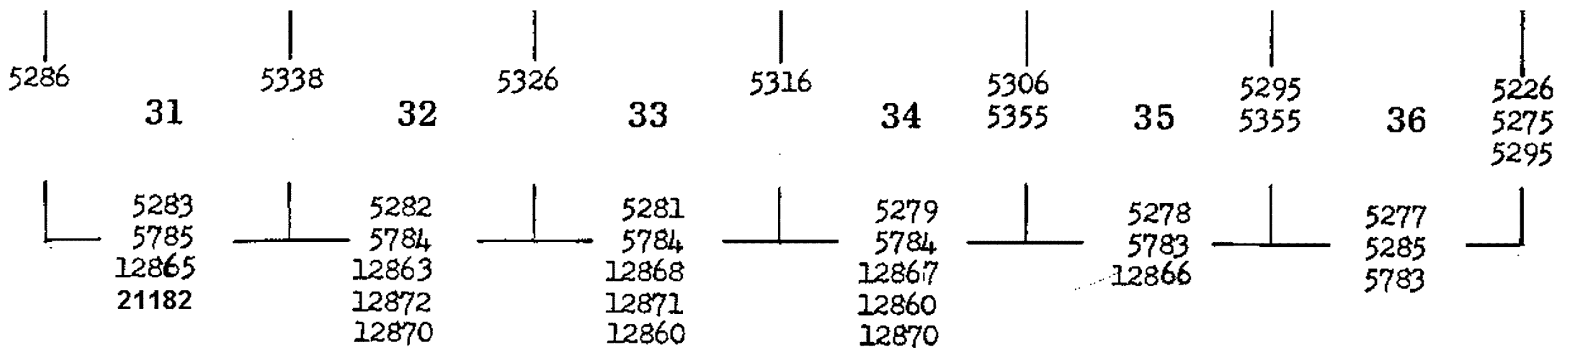

NOTE: SEE GLO MAP FOR T27½S R8W AND PAGE NUMBERS 12859 - 12871

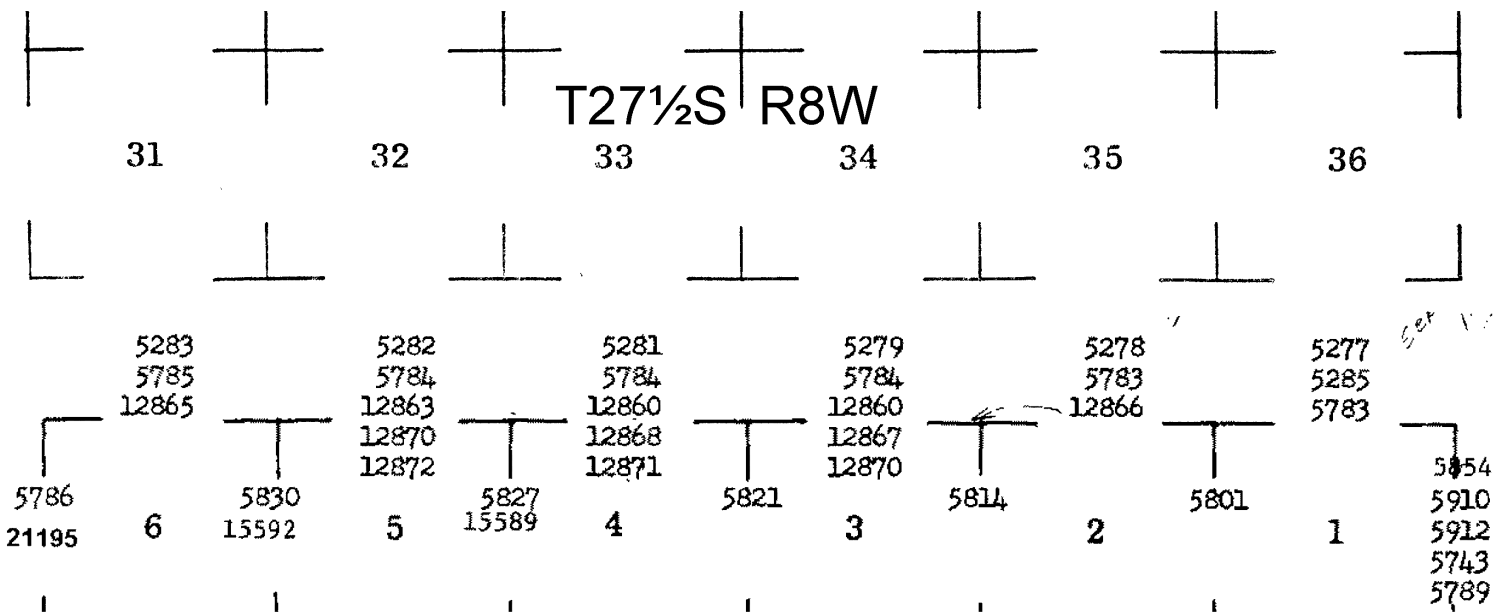

T28S R8W

