


Meanders of T. 22 S., R. 10 W.

CHAINS

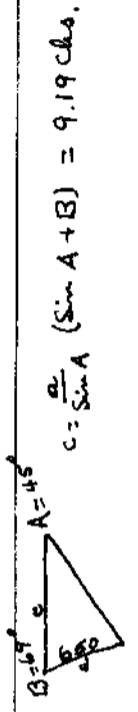

marked T 22 S R 10 W S 14  
M C B T.

Land, mountainous, 15.00 chs.  
Soil, sandy & 1st rate where level.  
Timber & underbrush, ash, willow &  
alder, dense 82.50 chs.

(The courses & distances give me  
in the notes I was unable to  
follow. The lines run into the  
river.)

July 7, 1894.

Across the river, base N.69°E. 7.11 chs. angle opposite  
45°. Distance to waters edge 9.19 and at

9.50

Set a post, 4 ft. long, 4 ins. sq., 24 ins. in the ground  
for meander cor. bet. secs. 14 & 15, marked T 22 S R  
10 W M C on S., S 14 on E., S 15 on W. faces, from  
which

A myrtle, 6 ins. diam., bears S.66°E. 10 lks. dist.  
marked T 22 S R 10 W S 14 M C B T.

A myrtle, 6 ins. diam., bears N.25°W. 25 lks. dist.  
marked T 22 S R 10 W S 15 M C B T.

From the meander cor. on the S. or left bank of the river,  
bet. secs. 14 & 15, I run with the meanders in sec. 15.

Var. 20°30'E.

The courses and distances given me in the notes, I was  
unable to follow but followed them as closely as  
practicable.

<u>Course</u>	<u>Chains</u>	
S.70°W.	36.50	Mill Creek mouth.
S.44°W.	1.60	Across Mill Creek.
S.84½°W.	4.10	Steep bluff of rock.
S.69½°W.	2.60	Steep bluff of rock.
S.64°W.	3.60	Steep bluff of rock.