

County Surveyor's Record, Douglas County, Oregon


Retracement of S. Bdy., T. 24 S., R. 3 E.

CHAINS

A fir, 24 ins. diam., bears S.40°E., 42 lks.  
dist., mkd. 1/4 S 6 B T

Along broken E. slope.

- 43.70 Asc. 287 ft. over SE. slope.
- 59.70 Spur, slopes E., desc. 301 ft. over NE. slope.
- 73.10 Draw, drains E., asc. 87 ft. over SE. slope.
- 78.50 Spur, slopes E., desc. 171 ft. over N. slope.
- 80.00 Set an iron post 3 ft. long, 1 in. diam., 28 ins. in the ground, for cor. of lots 8 and 9, sec. 1, and lots 5 and 12, sec. 6, with brass cap mkd.

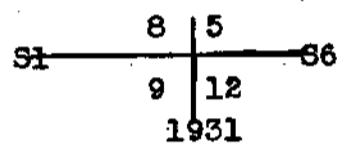

from which

A fir, 18 ins. diam., bears N.36°E., 46 lks.  
dist., mkd. S 6 L 5 B T

A fir, 16 ins. diam., bears S.38°W., 47 lks.  
dist., mkd. S 1 L 9 B T

Desc. 725 ft. over broken NE. slope.

- 86.10 Draw, drains NE.,
- 96.00 Spur, slopes NE.,

Dependent Resurvey of S. Bdy., T. 24 S., R. 3 E.

From the cor. of Tps. 24 and 25 S., R. 3 E.

S.89°51'W., on true line bet. secs. 1 and 36  
ASC. 86 ft. over E. slope, through heavy timber and  
medium undergrowth

- 2.50 Spur, slopes SE., asc. 710 ft. over SE. slope.
- 22.70 Draw, drains S.70°E., asc. 387 ft. over E., changing to NE. slope
- 31.80 Staley Ridge Trail, bears N W. and SE.,
- 32.80 Staley Ridge, bears NW. and SE., desc. 250 ft. over SW. slope, over bluffs.
- 39.54 The 1/4 sec. cor. of sec. 36 only, which is an iron post, 1 in. diam., 9 ins. above ground, firmly set, mkd. and witnessed as described in the official record