

County Surveyor's Record, Douglas County, Oregon

Dependent Resurvey of a Portion of the E. Bdy., T. 29 S., R. 7 W.

CHAINS

from which

A madrone, 12 ins. diam., bears S. 80° W., 109 lks. dist., marked  $\frac{3}{8}$  T29S. R7W CS BT.

A fir, 10 ins. diam., bears N. 61° W., 155 lks. dist., marked  $\frac{3}{8}$  S T29S R7W CS BT.

N. 0° 35' W., beginning new measurement.

Ascend 170 ft. over broken SE. slope.

22.45 Spur, slopes N. 60° E.; desc. 340 ft. over broken NE. slope.

38.53 The cor. of secs. 1, 6, 7 and 12, monumented with an iron post, 2 ins. diam., extending 8 ins. above ground, firmly set, marked and witnessed as described in the official record.

Land, mountainous. Soil, rocky clay. Timber, fir, cedar, madrone, maple and alder; undergrowth, vine maple, hazel, arrowwood, Oregon grape and fern.

Dependent Resurvey of a Portion of the Subdivisional Lines,  
T. 29 S., R. 7 W.  
(Restoring the 1854 survey by Nathaniel Ford)

From the cor. of secs. 13, 14, 23 and 24, monumented with an iron post, 2 ins. diam., extending 8 ins. above ground, firmly set, with brass cap marked and witnessed as described in the official record.

N. 0° 21' W., bet. secs. 13 and 14, marking and blazing the true line.


Descend 715 ft. over NE. slope, through heavy timber and dense undergrowth.

24.60 Kent Creek, 5 lks. wide, course N. 75° E.; asc. 380 ft. over S. slope.

30.15 Graded road, 20 lks. wide, bears E. and W.

39.34 Point for the  $\frac{1}{4}$  sec. cor. of secs. 13 and 14, at proportionate distance; there is no remaining evidence of the original corner.

Set an iron post, 3 ft. long, 1 in. diam., 28 ins. in the ground, with brass cap marked

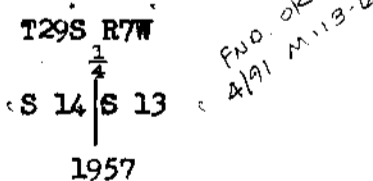

from which

A fir, 6 ins. diam., bears S. 47° E., 62 lks. dist., marked  $\frac{1}{4}$  S13 BT.

A fir, 8 ins. diam., bears N. 71° W., 98 lks. dist., marked  $\frac{1}{4}$  S14 BT.

Destroy bearing trees marked in 1957.

Ascend 170 ft. over S. slope.

46.50 Spur, slopes S. 70° E.; desc. 240 ft. over NE. slope.