

## County Surveyor's Record, Douglas County, Oregon

Dependent Resurvey of 6th Stan. Par. S., Portion of N. Bdy., of T. 28 S., R. 8 W.

CHAINS


Beginning at the standard corner of secs. 2 and 3, determined at record bearing and distance from the remaining original bearing tree:

A hemlock, 20 ins. diam., fallen and rotted, bears S.  $45^{\circ}$  W., 23 lks. dist., mkd. with a reversed B, on opened blaze.

This corner now becomes also the eastern terminus and corner of sec. 34, T.  $27\frac{1}{2}$  S., R. 8 W.

At the corner point

Set an iron post, 28 ins. long,  $2\frac{1}{2}$  ins. diam., 24 ins. in the ground, with brass cap mkd.

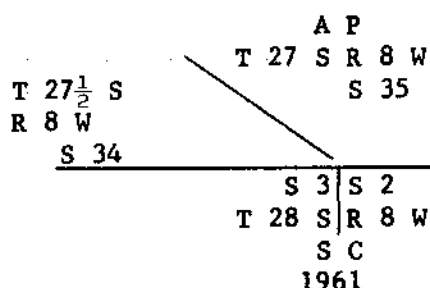

from which new bearing trees:

A cedar, 28 ins. diam., bears S.  $15^{\circ}$  E., 75 lks. dist., mkd. T28S R8W S2 SC BT.

A fir, 25 ins. diam., bears S.  $84\frac{1}{4}^{\circ}$  W., 23 lks. dist., mkd. T28S R8W S3 SC BT and cruiser marks in the bark.

A hemlock, 10 ins. diam., bears N.  $88^{\circ}$  W., 114 lks. dist., mkd. T $27\frac{1}{2}$ S R8W S34 BT.

A hemlock, 10 ins. diam., bears N.  $11\frac{1}{4}^{\circ}$  W., 26 lks. dist., mkd. T27S R8W S35 AP BT.

The corner is located 55 lks. N. of a creek, 5 lks. wide, course S.  $85^{\circ}$  E.

N.  $89^{\circ} 55'$  W., on the N. bdy. of sec. 3, marking and blazing the true line.

Ascend 62 ft. over broken SE. slope, through heavy old growth timber and moderate undergrowth.

- 6.20 Spur, slopes S.; desc. 6 ft. over SW. slope.
- 6.95 Draw, drains S.  $20^{\circ}$  E.; asc. 68 ft. over general SE. slope.
- 11.90 Spur, slopes S.; desc. 34 ft. over SW. slope.
- 13.75 Creek, 2 lks. wide, course S.  $20^{\circ}$  E.; asc. 180 ft. over SE. slope.
- 21.50 Spur, slopes S.; desc. 31 ft. over SW. slope.
- 25.30 Ravine, drains SE.; asc. 37 ft. over SE. slope.
- 27.50 Wet ravine, drains S.  $70^{\circ}$  E.; asc. 480 ft. over general E. slope.
- 36.50 Road, 15 lks. wide, graded and maintained, bears N.  $10^{\circ}$  E. and S.  $10^{\circ}$  W.