

Dependent Resurvey of 6th Stan. Par. S., Portion of N. Bdy. of T. 28 S., R. 8 W.


CHAINS

A hemlock, 9 ins. diam., bears N. $75\frac{1}{2}^{\circ}$ W., 90 lks. dist., mkd. T27S R8W S31 CS BT.

This point now becomes also the western terminus and cor. of sec. 32, T. $27\frac{1}{2}$ S., R. 8 W.

At the corner point

Set an iron post, 28 ins. long, $2\frac{1}{2}$ ins. diam., 24 ins. in the ground, with brass cap mkd.

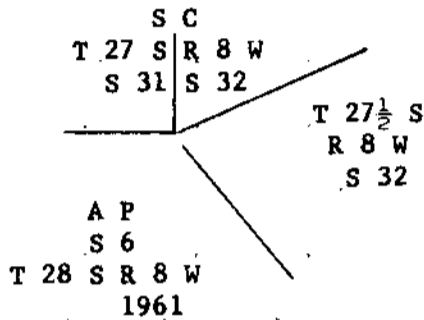

from which new bearing trees:

A fir, 42 ins. diam., bears N. $80\frac{1}{2}^{\circ}$ E., 69 lks. dist., mkd. T27S R8W S32 SC BT.

A fir, 30 ins. diam., bears S. 43° E., 185 lks. dist., mkd. T28S R8W S6 AP BT.

Dependent Resurvey of the Sixth Standard Parallel South
Along a Portion of the S. Bdy. of T. 27 S., R. 8 W.,
Willamette Meridian, Oregon
(Restoring the 1896 Survey by William P. Heydon)

From the standard cor. of secs. 2 and 3, T. 28 S., R. 8 W., hereinbefore described.

N. $87^{\circ} 49'$ W., on the S. bdy. of sec. 35.

Ascend 65 ft. over broken SE. slope, through heavy old growth timber and dense undergrowth.

6.20 Spur, slopes S.; desc. 5 ft. over SW. slope.


6.80 The standard cor. of secs. 34 and 35, determined at record bearing and distance from the original NE. bearing tree:

A fir, 54 ins. diam., bears N. 70° E., 49 lks. dist., mkd. in the bark T27S R8W S35 BT.

A fir, 60 ins. diam., turned out and dead, bears N. 20° W., 26 lks. dist., mkd. in the bark T27S R8W S34 BT. (Record, 60 lks. dist.)

At the corner point

Set an iron post, 28 ins. long, $2\frac{1}{2}$ ins. diam., 22 ins. in the ground, with brass cap mkd.

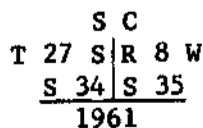

from which new bearing trees: