

County Surveyor's Record, Douglas County, Oregon

Dependent Resurvey, Portion Subdivisional Lines, T. 22 S., R. 8 W.

CHAINS

74.25 Spur, slopes NW.; desc. 90 ft. over NE. slope.

78.92 The cor. of secs. 5 and 6, on the N. bdy. of the Tp., heretofore described.

Land, mountainous.
Soil, sandy and rocky.
Timber, fir, maple, oak, and alder; undergrowth, salal, poison oak, vine maple, Oregon grape, and hazel.

Dependent Resurvey of a Portion of the Boundaries of Claim No. 49, T. 22 S., R. 8 W., Willamette Meridian, Oregon
(Restoring the 1856 survey by Dennis Hathorn)

Beginning at the cor. of Claims 48, 49, and 58, in the SW $\frac{1}{4}$ of sec. 7. The claim cor. has been remonumented with a steel rod, $\frac{3}{4}$ in. diam., 4 ins. above ground, firmly set, from which the remaining original bearing tree,

A fir, 28 ins. diam., bears N. 33° W., 50 lks. dist., with no marks remaining on opened and burned blaze. The tree was reblazed by James W. Byron in 1962 alongside the original blaze, and is marked SW CL49 CS BT.

a bearing tree marked by A. R. Evans in 1951,

A dead chinquapin, 10 ins. diam., bears S. 58° W., 33 lks. dist., with no marks remaining on opened and burned blaze.

a bearing tree marked by James W. Byron in 1962,


A fir, 13 ins. diam., bears S. 36° E., 90 lks. dist., with a healed blaze.

and a bearing tree not of record,

A burned fir stump, 12 ins. diam., bears S. 49° W., 48 lks. dist., with scribe marks BT C48 CS visible on opened and burned blaze.

At the corner point

Set an iron post, 28 ins. long, 2 $\frac{1}{2}$ ins. diam., 21 ins. in the ground, with brass cap marked

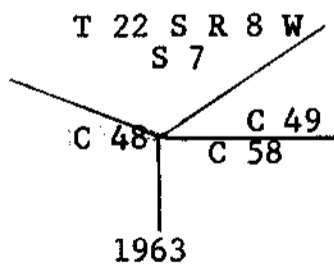

Reset steel rod alongside iron post.

N. 39° 25' E., on a blank line along the NW. bdy. of Claim No. 49.

107.35 Intersect the line bet. secs. 5 and 6 at the closing cor. of secs. 5 and 6, heretofore described. The cor. of secs. 5, 6, 7, and 8, bears S. 0° 13' W., 9.80 chs. dist.

145.75 Point for closing cor. at intersection with the E. and W. center line of sec. 5, hereinafter described.