

County Surveyor's Record, Douglas County, Oregon

16608

Dependent Resurvey, Portion of Subdivisional Lines,
T. 33 S., R. 5 W., Willamette Meridian, Oregon

CHAINS

and new bearing trees

A black oak, 24 ins. diam., bears N. 79 1/2° E., 102 lks. dist., mkd. T33S R5W S28 CCC BT.


A cedar, 10 ins. diam., bears S. 26° W., 31 1/2 lks. dist., mkd. T33S R5W S33 CCC BT.

From this point, cor. No. 1 of St. Peters Quartz Lode, Mineral Survey No. 142, bears S. 70° 12' W., 9.515 chs. dist., determined at record bearing and distance from the only remaining original bearing tree:

A black oak, 21 ins. diam., bears N. 10° W., 21 lks. dist., with illegible scribe marks visible on opened double blaze.

At the corner point

Set an iron post, 28 ins. long, 2 1/2 ins. diam., 24 ins. in the ground, with brass cap mkd.

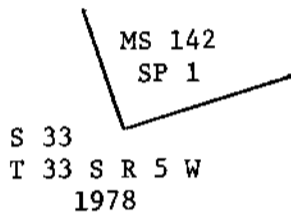

from which new bearing trees

A ponderosa pine, 15 ins. diam., bears N. 59 1/4° E., 95 1/2 lks. dist., mkd. MS142 SP1 BT.

A white oak, 5 ins. diam., bears N. 33 1/4° W., 62 1/2 lks. dist., mkd. S33 BT.

From this same point, cor. No. 4 of St. Peters Quartz Lode, Mineral Survey No. 142, identical with cor. No. 1 of Dividend Quartz Lode, Mineral Survey No. 141, bears N. 70° 12' E., 12.935 chs. dist., herinbefore described.


Ascend 175 ft. over SE. slope.

38.50 Spur, slopes S. 30° W.; desc. 10 ft. over W. slope.

39.05 Intersect line 1-2 of St. Peters Quartz Lode, Mineral Survey No. 142.

Point for the crossing closing cor. of secs. 28 and 33 with line 1-2 of St. Peters Quartz Lode.

Set an iron post, 28 ins. long, 2 1/2 ins. diam., 24 ins. in the ground, with brass cap mkd.

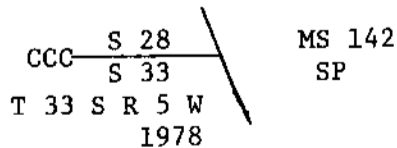

from which

A ponderosa pine, 20 ins. diam., bears S. 1 1/4° W., 73 lks. dist., mkd. T33S R5W S33 CCC BT.

A fir, 26 ins. diam., bears N. 32 1/2° W., 52 1/2 lks. dist., mkd. T33S R5W S28 CCC BT.