

County Surveyor's Record, Douglas County, Oregon

17589

Dependent Resurvey of
a Portion of the Subdivisional Lines,
T. 33 S., R. 6 W., Willamette Meridian, Oregon

CHAINS

28.50 Spur, slopes E.; desc. over NE. slope.

37.10 Creek, 3 lks. wide, course S. 25° E.; asc. over SW. slope.


38.74 The 1/4 sec. cor. of secs. 17 and 18, determined at record bearing and distance from the remains of the original bearing trees

A black oak, 22 ins. diam., bears N. 45° E., 25 lks. dist., with scribe marks BT visible in reverse and relief on overgrowth.

A root hole, bears West, 14 lks. dist.

At the corner point

Set an aluminum post, 28 ins. long, 2 1/2 ins. diam., 22 ins. in the ground, with aluminum cap mkd.

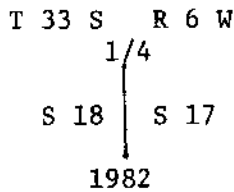

from which new bearing trees

A ponderosa pine, 29 ins. diam., bears S. 86 3/4° E., 62 1/2 lks. dist., mkd. 1/4 S17 BT.


A fir, 24 ins. diam., bears S. 55 3/4° W., 83 lks. dist., mkd. 1/4 S18 BT.

N. 2° 49' E., beginning new measurement.

Ascend over SW. slope.

21.90 Ridge, bears E. and W., also dirt road, 15 lks. wide, bears same; desc. over broken NW. slope.

44.73 The cor. of secs. 7, 8, 17, and 18, perpetuated and recorded by the County Surveyor's Office in 1963, monumented with an iron post, 2 ins. diam., firmly set, projecting 8 ins. above ground, with brass cap mkd.

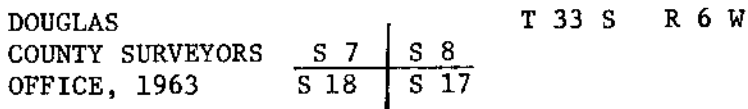

from which the remains of the original bearing trees

A fir snag, 20 ins. diam., bears N. 50 3/4° E., 23 1/2 lks. dist., no marks visible.
(Record, N. 46° E., 22 lks.)

A root hole, bears S. 25° E., 22 lks. dist., alongside of which is lying a decayed madrone, size indeterminate, no marks visible.

A fir snag, 34 ins. diam., bears N. 50° W., 29 lks. dist., no marks visible.
(Record, N. 52° W.)

and bearing trees mkd. by the County Surveyor's Office