

# County Surveyor's Record, Douglas County, Oregon


17599

Dependent Resurvey of a Portion of the  
Subdivisional Lines, T. 23 S., R. 7 W.,  
Willamette Meridian, Oregon

CHAINS

(Restoring the survey by Thomas H. Hutchinson and  
Ambrose N. Armstrong in 1857-58, the resurvey by  
Floyd A. Brooks in 1961-62, and the resurvey by  
Harvey E. Wofford in 1979)

Beginning at the cor. of secs. 31 and 32 only, on the S. bdy. of the Tp., monumented with an iron post, 1 1/4 ins. diam., firmly set, projecting 12 ins. above ground, with brass cap mkd.

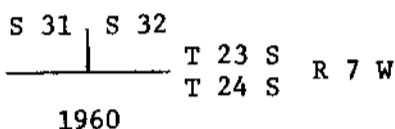

from which the remaining original bearing trees

A white oak, 38 ins. diam., bears S. 10° W.,  
54 lks. dist., with a healed blaze.

A fir, 55 ins. diam., bears N. 13° W., 160  
lks. dist., with a healed blaze.

and the remains of the bearing trees mkd. by Byron

A fir, 17 ins. diam., bears N. 14° E., 20  
lks. dist., with a healed blaze.

A fir snag, 12 ins. diam., bears N. 57 1/2° W.,  
58 lks. dist., with a healed blaze.

and a new bearing tree

A fir, 19 ins. diam., bears N. 26° W., 62 1/2 lks.  
dist., mkd. T23S R7W S31 BT.

N. 0° 22' E., bet. secs. 31 and 32, marking and blazing the true line.

Ascend SE. slope, through heavy timber and dense undergrowth.


30.70

Ridge, bears N. 40° W. and S. 40° E.; desc. NE. slope.

40.11

Point for the 1/4 sec. cor. of secs. 31 and 32, at proportionate distance; there is no remaining evidence of the original corner.

Set an aluminum post, 28 ins. long, 2 1/2 ins. diam., 24 ins. in the ground, with aluminum cap mkd.

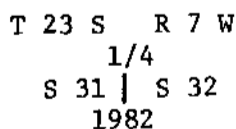

from which

A maple, 6 ins. diam., bears N. 65° E., 100 lks.  
dist., mkd. 1/4 S32 BT.

A maple, 26 ins. diam., bears S. 35° W., 67 lks.  
dist., mkd. 1/4 S31 BT.

Descend NE. slope.

55.60

Bullock Road, paved, 40 lks. wide, bears S. 85° E. and N. 85° W.