

Date: 5/17/2011 By: JC
 This survey consists of:
 Map: T26S R7W 2011-1
 Narrative: VOL 56
 Corner Rpt: PAGE 22269

TOWNSHIP 26 SOUTH, RANGE 7 WEST, OF THE WILLAMETTE MERIDIAN, OREGON

RETRACEMENT

This plat represents the entire survey record of the retracement of a portion of the subdivisional lines, T.26 S., R. 7 W., Willamette Meridian, Oregon.

The history of surveys pertaining to this retracement is as follows:

In 1855, Dennis Hathorn, U.S. Deputy Surveyor, surveyed the north, south, and west boundaries and a portion of the subdivisional lines.

In 1881, Addison R. and Samuel C. Flint, U.S. Deputy Surveyors, retraced the west boundary and portions of the north and south boundaries, and completed the subdivisional lines.


In 1959, Irving Zirpel, Jr. and Leo J. Martin, Cadastral Surveyors, dependently resurveyed a portion of the west boundary and the subdivisional lines.

In 1969, Lynn M. Roseberry, Cadastral Surveyor, dependently resurveyed a portion of the subdivisional lines.

In 1971-74, Peter A. Peterson, Daniel L. Berry, Gordon S. Popken, and Harvey E. Wofford, Cadastral Surveyors, dependently resurveyed a portion of the south boundary and a portion of the subdivisional lines.

In 2001-02, Timothy J. Moore, Cadastral Surveyor and Robert H. Browning, Surveying Technician, dependently resurveyed a portion of the south boundary and subdivisional lines and subdivided sections 21 and 32.

Described by Moore and Browning in 2001-02. 1/4 Cor. Sec. 31 Sec. 32

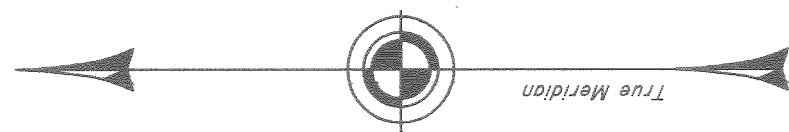

N $0^{\circ}37'20''$ E
 2637.88'

Latitude 43°15'28.10"N.
 Longitude 123°33'54.48"W.
 (NAD 1983 (CORS 96))

Described by Peterson, et al, in 1971-74. Sec. 31 Sec. 32 T. 26 S.
 Sec. 6 Sec. 5 T. 27 S.

We, Timothy J. Moore, Cadastral Surveyor, and Robert H. Browning, Surveying Technician, HEREBY CERTIFY upon honor, that in pursuance of Special Instructions bearing date of the 8th day of March, 2004, and the 16th day of March, 2007, have retraced a portion of the subdivisional lines, Township 26 South, Range 7 West, Willamette Meridian, Oregon. Said retracement has been executed in strict conformity with said Special Instructions, the Manual of Instructions for the Survey of the Public Lands of the United States, 1973, and in specific manner described on this plat.

Timothy J. Moore
 Cadastral Surveyor

Robert H. Browning
 Surveying Technician

March 3, 2011
 Date

March 6, 2011
 Date

- LEGEND
- ◊ Original corner previously remonumented
 - Corner previously reestablished



UNITED STATES DEPARTMENT OF THE INTERIOR
 BUREAU OF LAND MANAGEMENT

Portland, Oregon

The retracement represented by this plat, having been correctly executed in accordance with the requirements of law and the regulations of this Bureau, is hereby accepted.

For the Director

Mary J. M. Husted

Chief Cadastral Surveyor of Oregon

March 18, 2011
 Date