


Township N. 20 South Range N. 4 West Willamette Meridian.

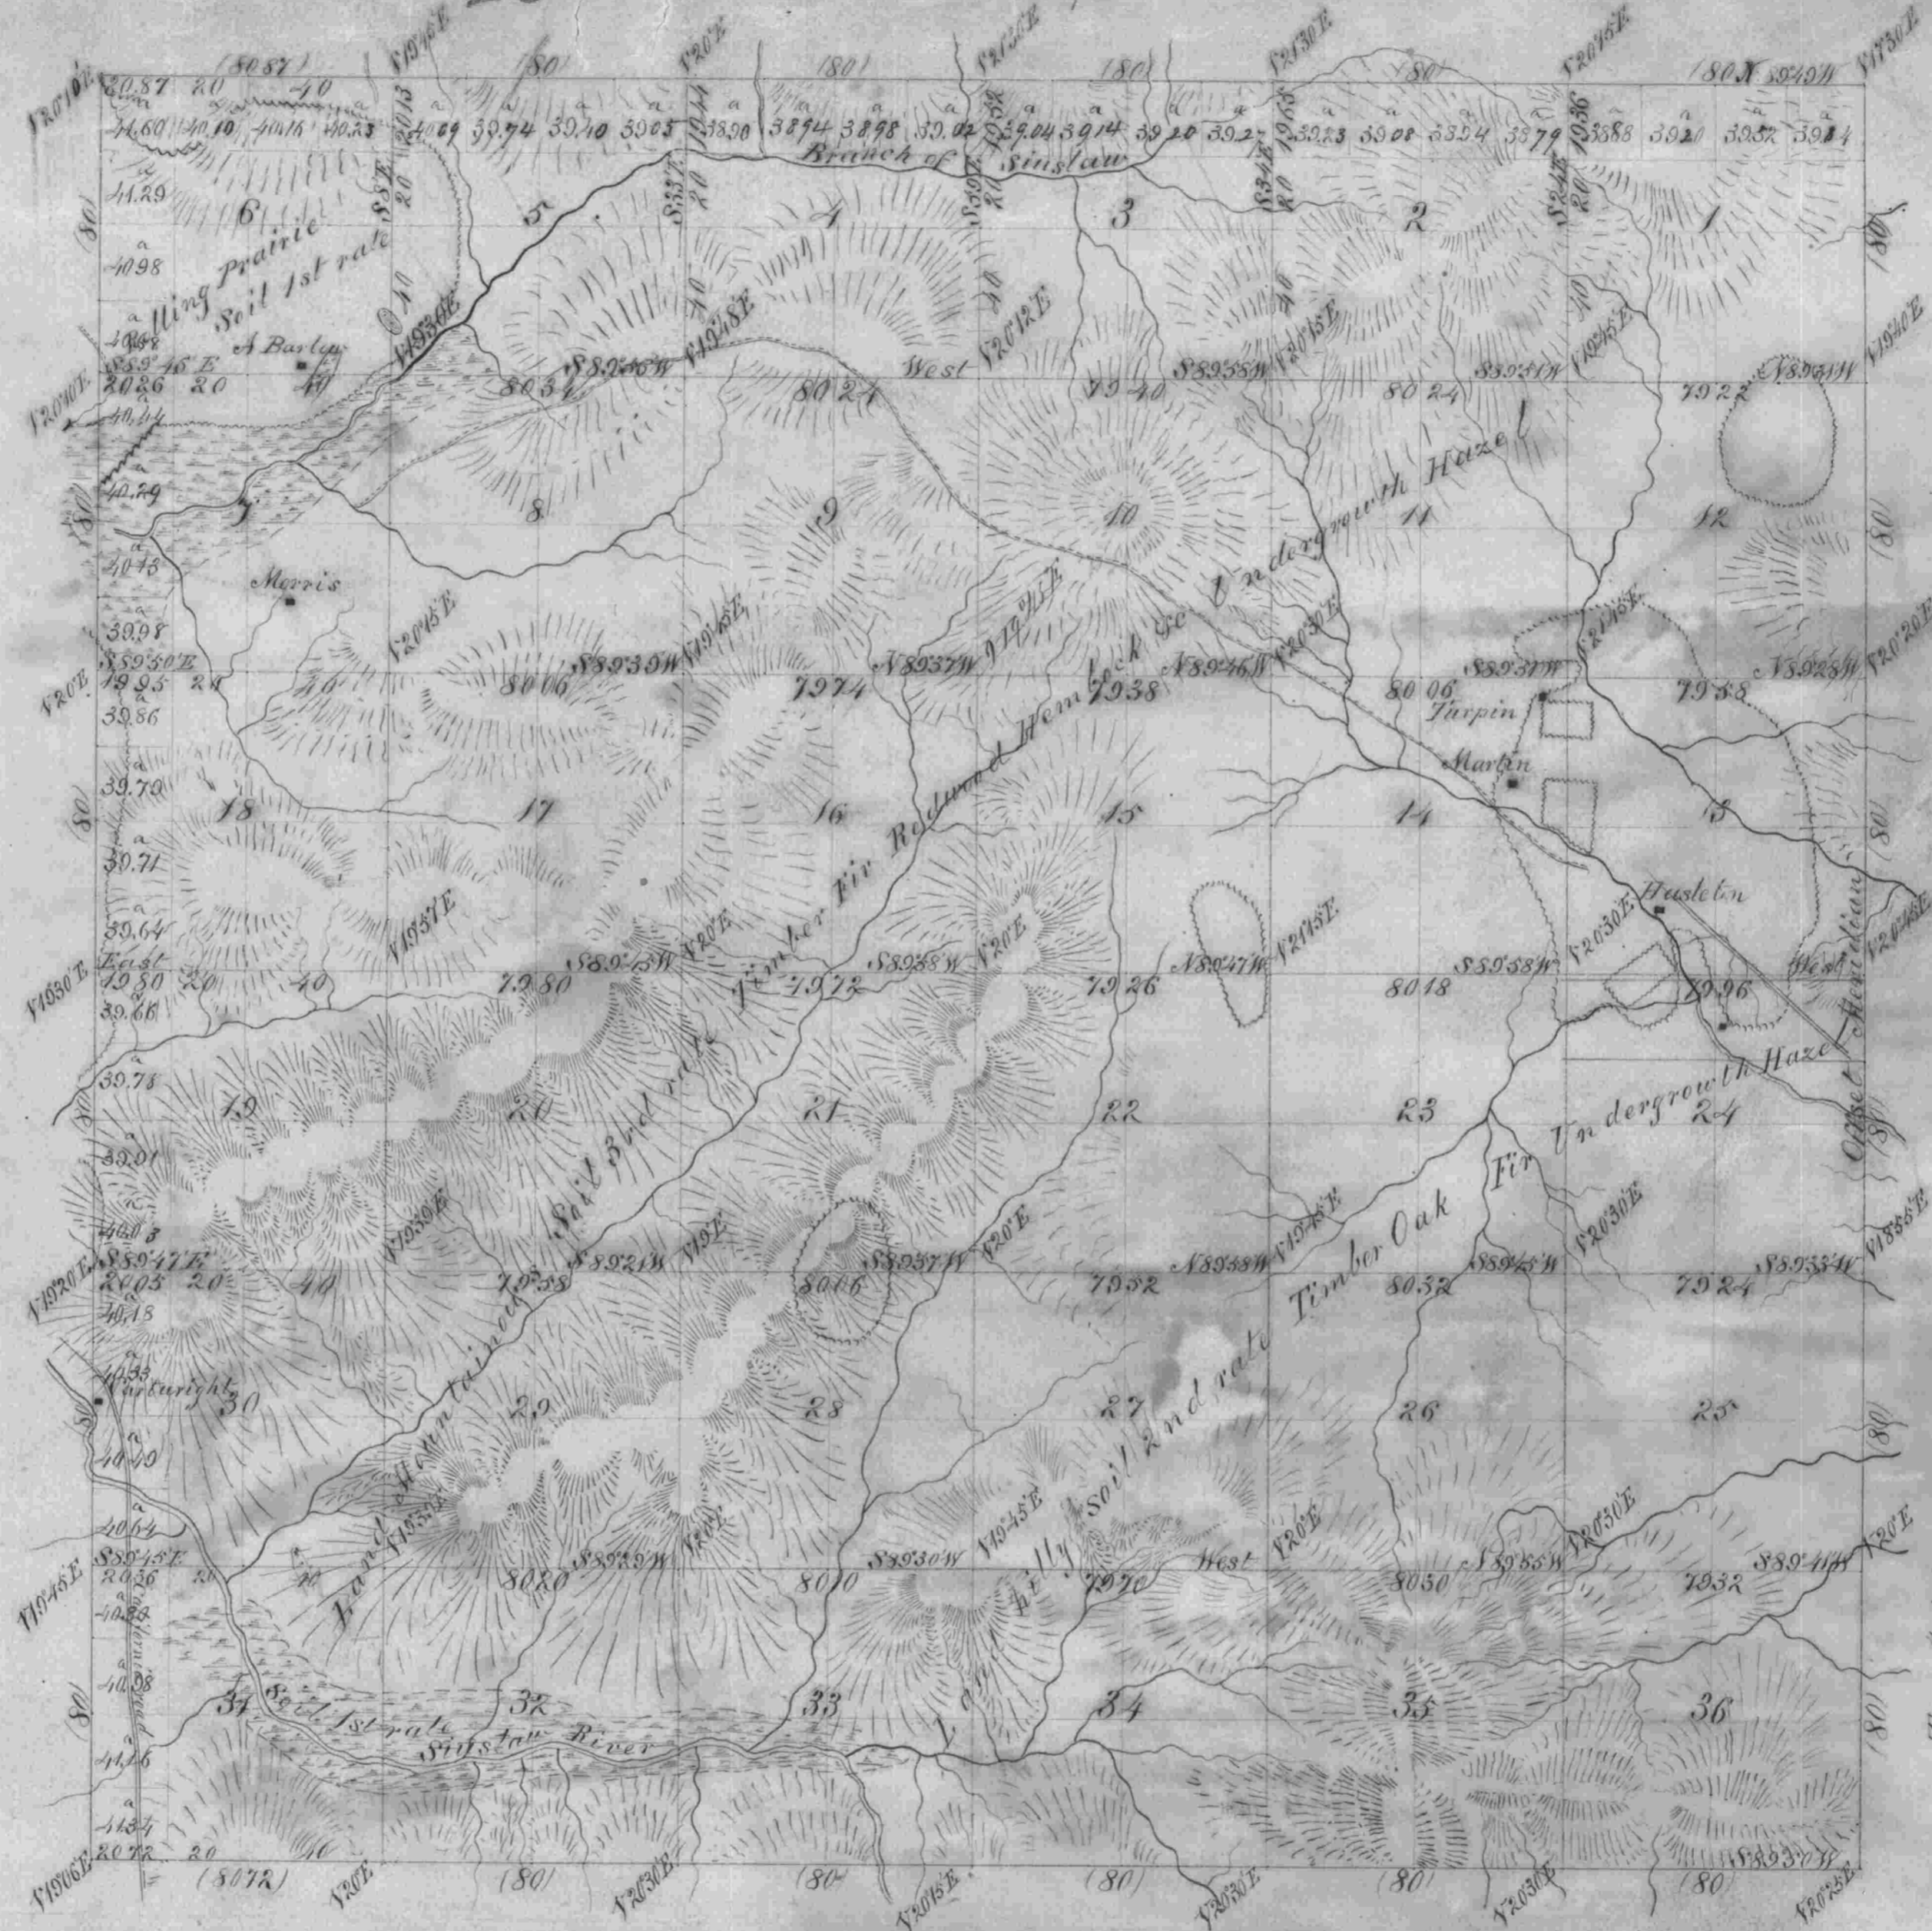

True Meridian
 Van. from 25° 45' 11" 1737 West
 Scale 40 chains to an inch.

| Surveys Designated | By Whom Surveyed | Contract No | Date | Acres of Survey | When Surveyed |
|-----------------------|------------------|-------------|-------------------------------|-----------------|----------------------------|
| Township Lines | Harvey Gordon | 119 | October 17 th 1854 | 12 00 72 | Sept 8 th 1854 |
| Subdivisions | Harvey Gordon | 119 | October 17 th 1854 | 53 74 04 | Sept 24 th 1854 |
| Total number of acres | | | | 23,034, 46 | |

The above Map of Township N. 20 South of Range N. 4 West of the Willamette Meridian Territory of Oregon is strictly conformable to the field notes of the survey thereof in file in this office which have been examined and approved.
 Surveyor General's Office
 Salem September 21st 1855
 C. K. Gardner
 Surv. Gen. of Oregon