


# TOWNSHIP 21 SOUTH, RANGE 6 WEST, OF THE WILLAMETTE MERIDIAN, OREGON.

## DEPENDENT RESURVEY



Mean magnetic declination 19°15' East

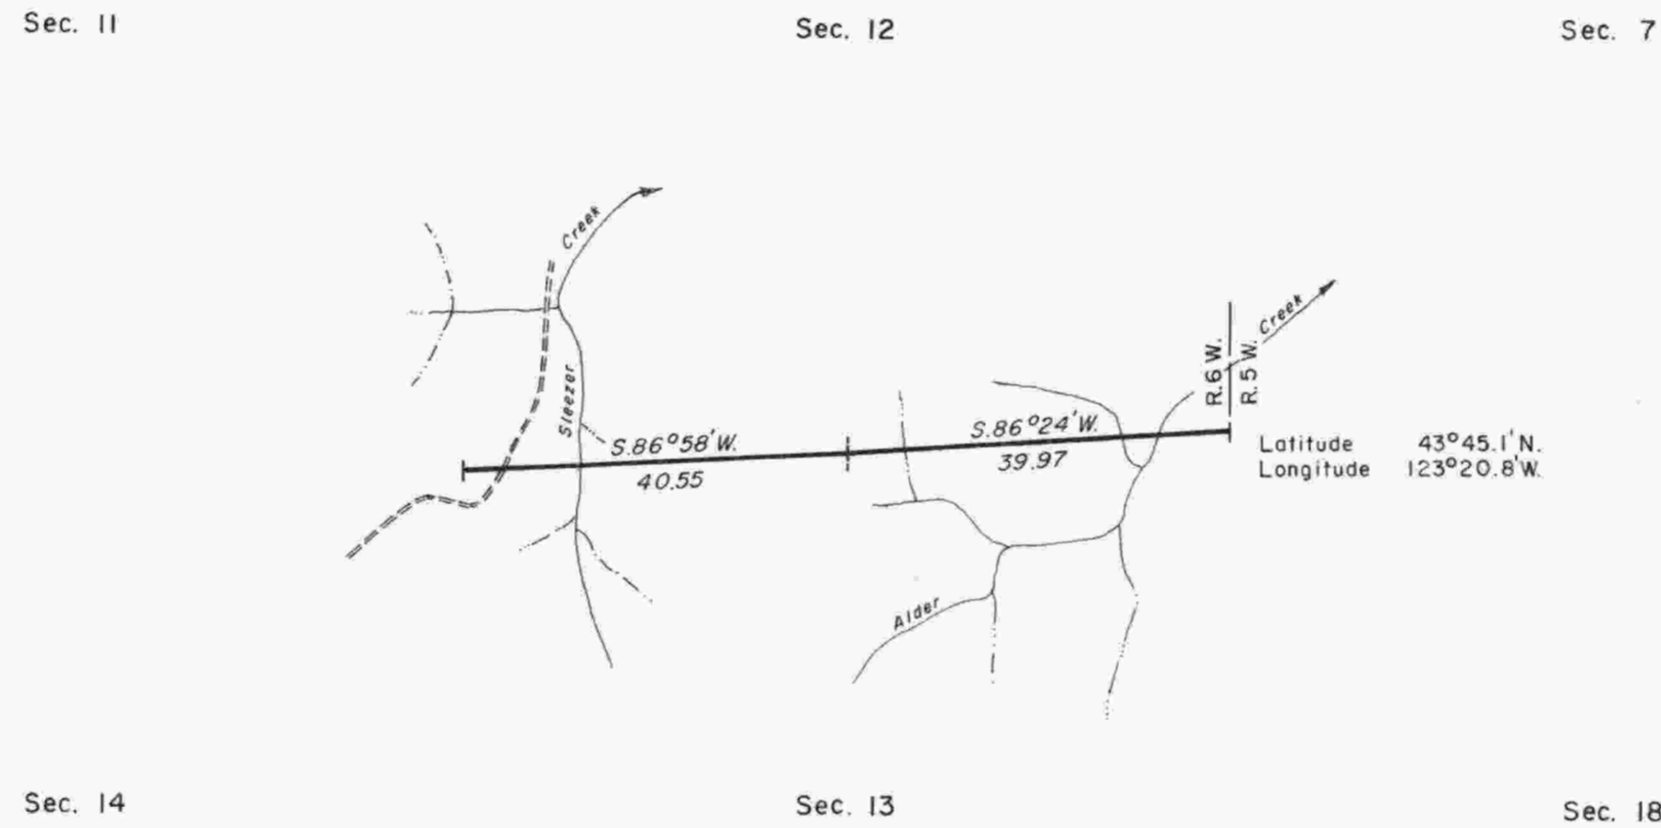

A history of surveys is contained in the field notes.

This plat represents a dependent resurvey of a portion of the subdivisional lines, T. 21 S., R. 6 W., Willamette Meridian, Oregon, designed to restore the corners in their true original locations according to the best available evidence.

The survey was executed by Lance J. Bishop and Wayne L. Rogers, Cadastral Surveyors, beginning October 4, 1983, and completed October 12, 1983, pursuant to Special Instructions dated May 13, 1983, under Group Number 1158, Oregon.

Timber in this area consists of fir, hemlock, oak, maple, madrone, cedar, and ash.

UNITED STATES DEPARTMENT OF THE INTERIOR  
BUREAU OF LAND MANAGEMENT  
Portland, Oregon December 6, 1985

This plat is strictly conformable to the approved field notes, and the survey, having been correctly executed in accordance with the requirements of law and the regulations of this Bureau, is hereby accepted.

For the Director

*William W. Glenn*

Chief Cadastral Surveyor of Oregon

