


Township No 22 South Range No 5 West Willamette Meridian

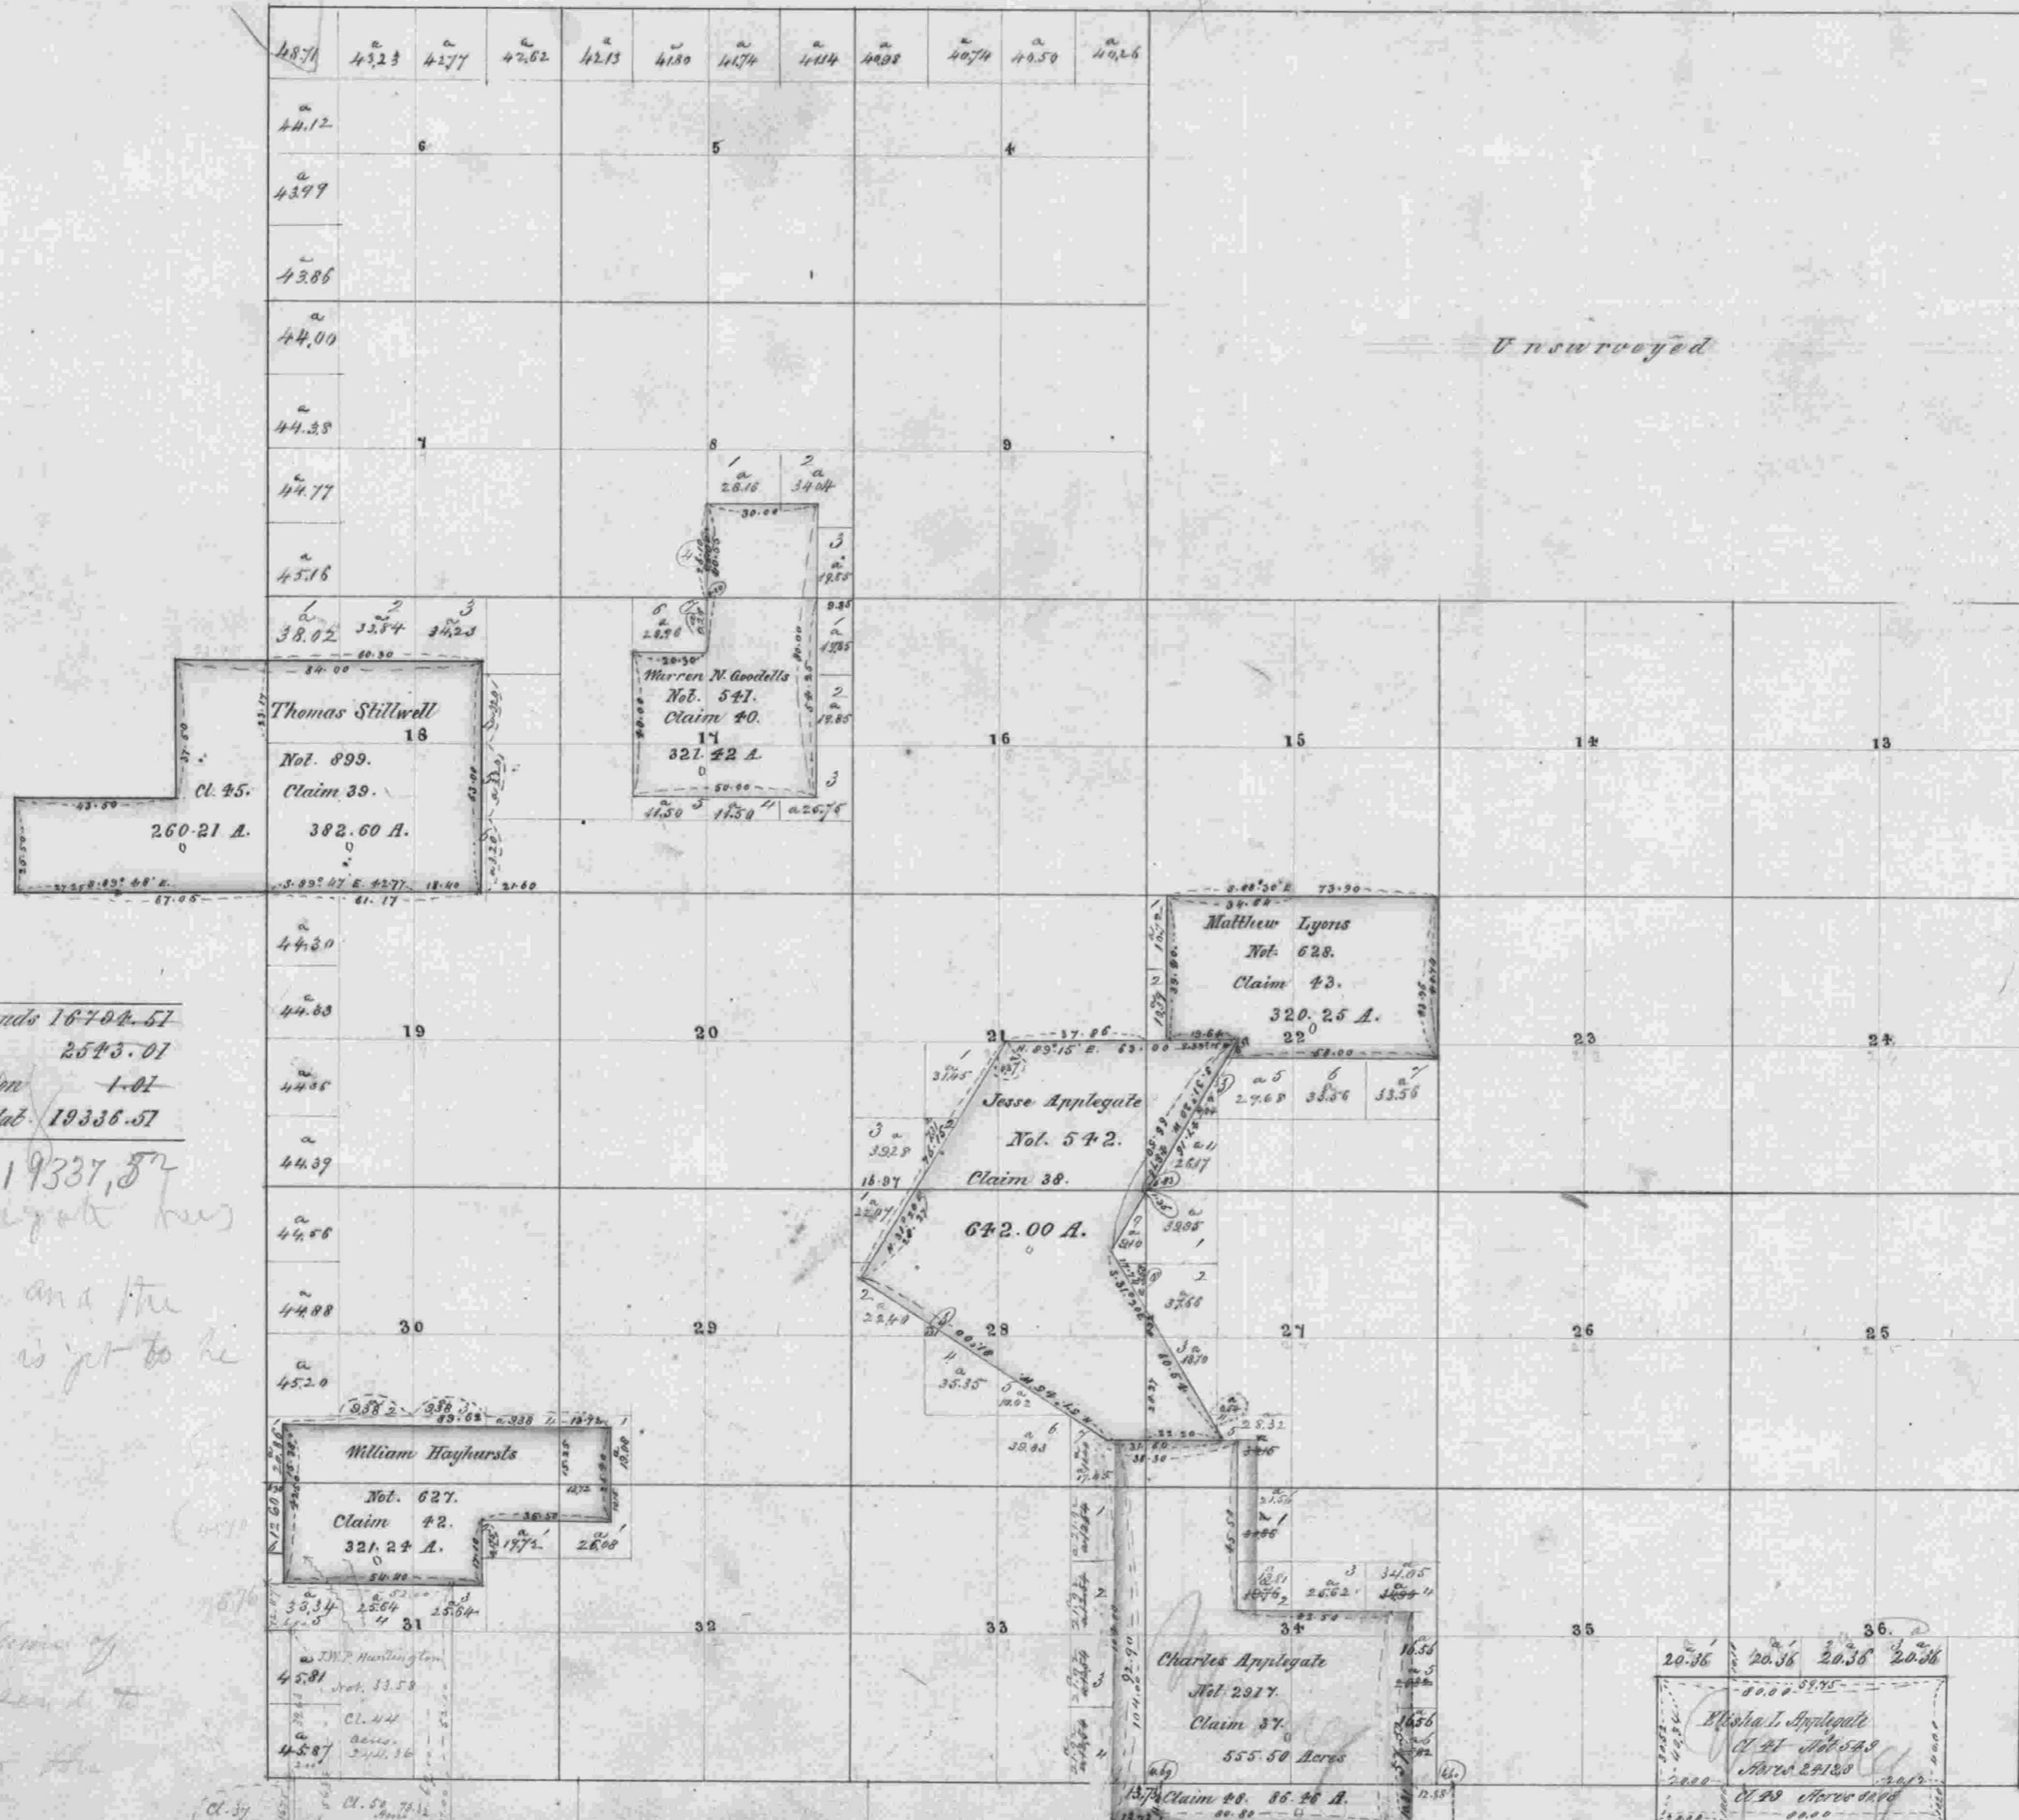

Aggregate Area of public lands 16784.57
 Private Surveys 2543.01
 Deduct error in computation 1.01
 Total returns on Township plat 19336.57

19337.57

Map of Jesse Applegate has
 been added and the
 map of Huntington is yet to be
 made

into plat of claims of
 Applegate to send to
 Dept. of the Interior

Cl. 37
 Cl. 38
 Cl. 39
 Cl. 40
 Cl. 41
 Cl. 42
 Cl. 43
 Cl. 44
 Cl. 45

The above Map of the survey of Claims in Township No 22 South Range No 5 West of the Willamette Meridian Territory of Oregon is strictly conformable to the field notes of the Surveys thereof on file in this Office, which have been examined and approved.

Surveyor General's Office
 Salem May 20th 1858

John S. Lieber,
 Sur. Gen. of Oregon