
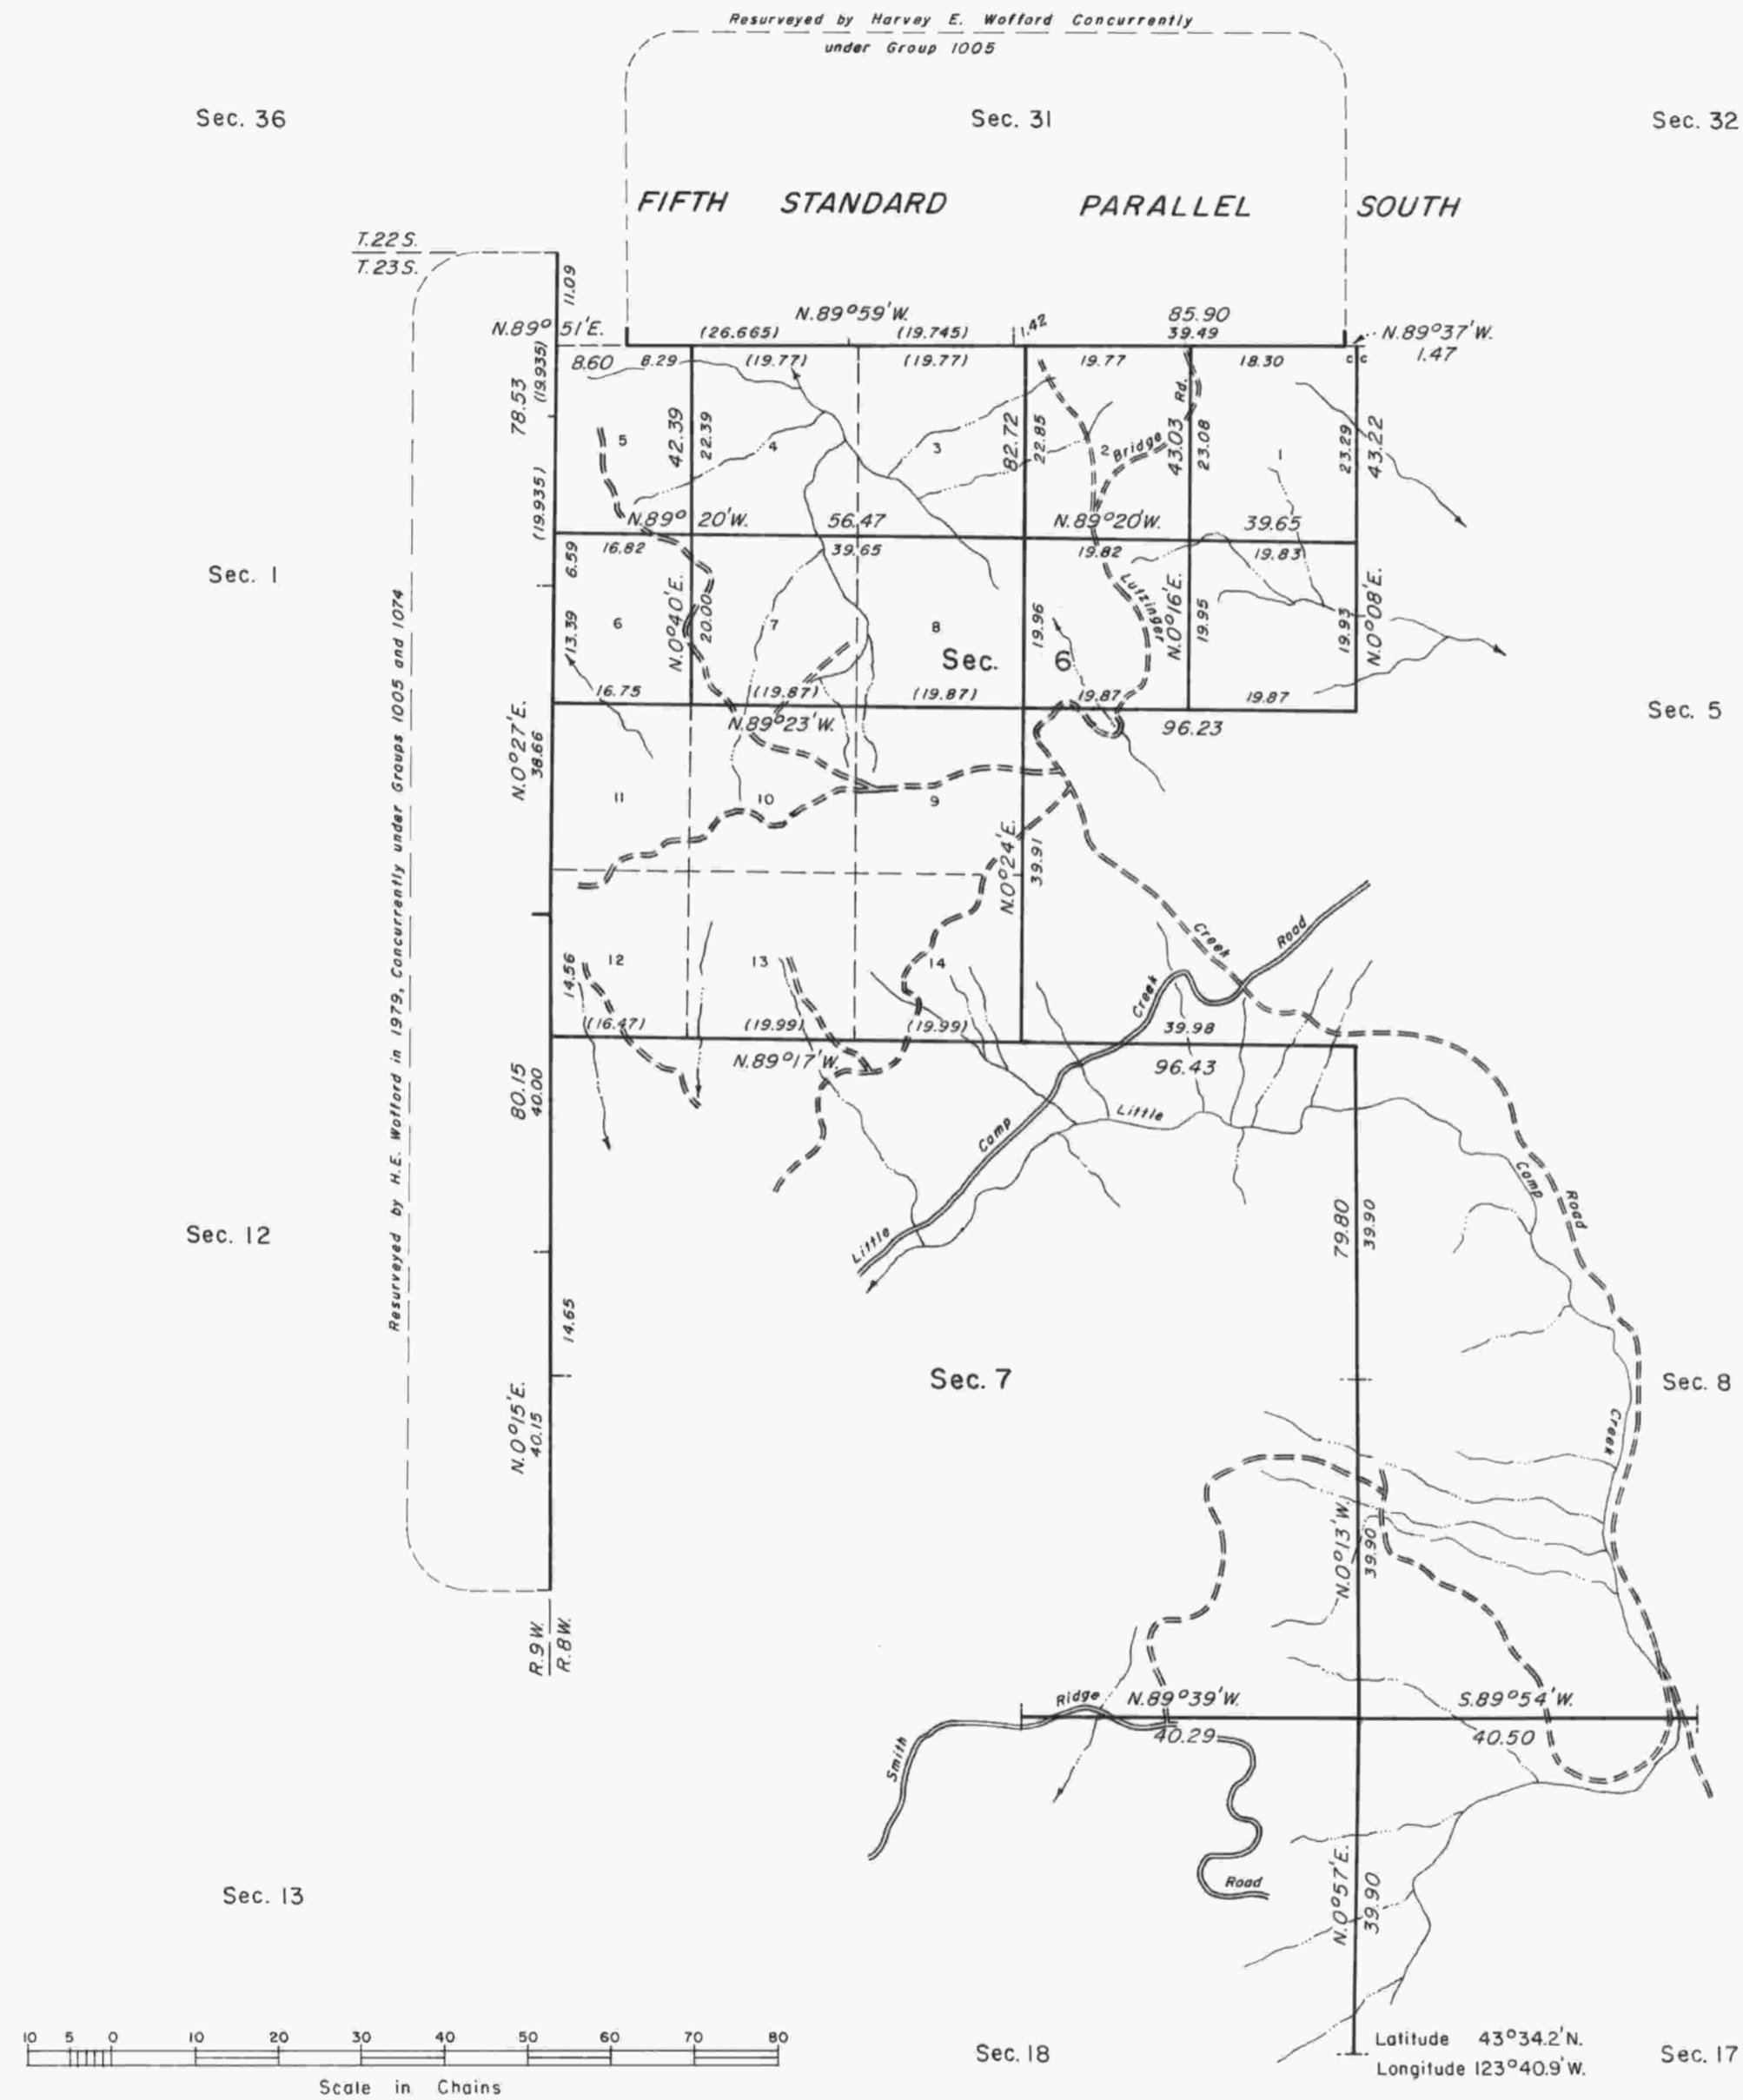


TOWNSHIP 23 SOUTH, RANGE 8 WEST, OF THE WILLAMETTE MERIDIAN, OREGON.

DEPENDENT RESURVEY AND SUBDIVISION OF SECTION 6

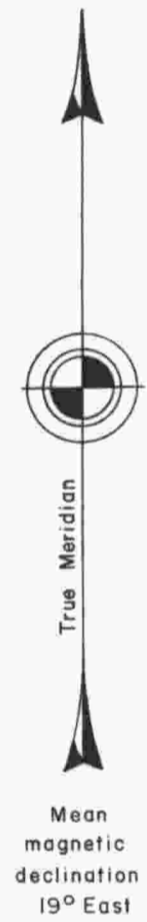

A history of surveys is contained in the field notes.

This plat represents a dependent resurvey of a portion of the subdivisional lines, T. 23 S., R. 8 W., Willamette Meridian, Oregon, designed to restore the corners in their true original locations according to the best available evidence, and the subdivision of section 6.

The lottings and areas are as shown on the plat approved June 27, 1895.

The survey was executed by Harvey E. Wofford, Cadastral Surveyor, beginning July 28, 1980 and completed December 17, 1980, pursuant to Special Instructions dated December 7, 1979, and Supplemental Special Instructions dated October 17, 1980, for Group No. 1005, Oregon.

Timber in this area consists of fir, hemlock, and cedar.

UNITED STATES DEPARTMENT OF THE INTERIOR
BUREAU OF LAND MANAGEMENT
Portland, Oregon April 14, 1983

This plat is strictly conformable to the approved field notes, and the survey, having been correctly executed in accordance with the requirements of law and the regulations of this Bureau, is hereby accepted.

For the Director

William W. Glenn

Chief Cadastral Surveyor of Oregon