


TOWNSHIP 24 SOUTH, RANGE 6 WEST, OF THE WILLAMETTE MERIDIAN, OREGON

DEPENDENT RESURVEY AND SUBDIVISION OF SECTION 15

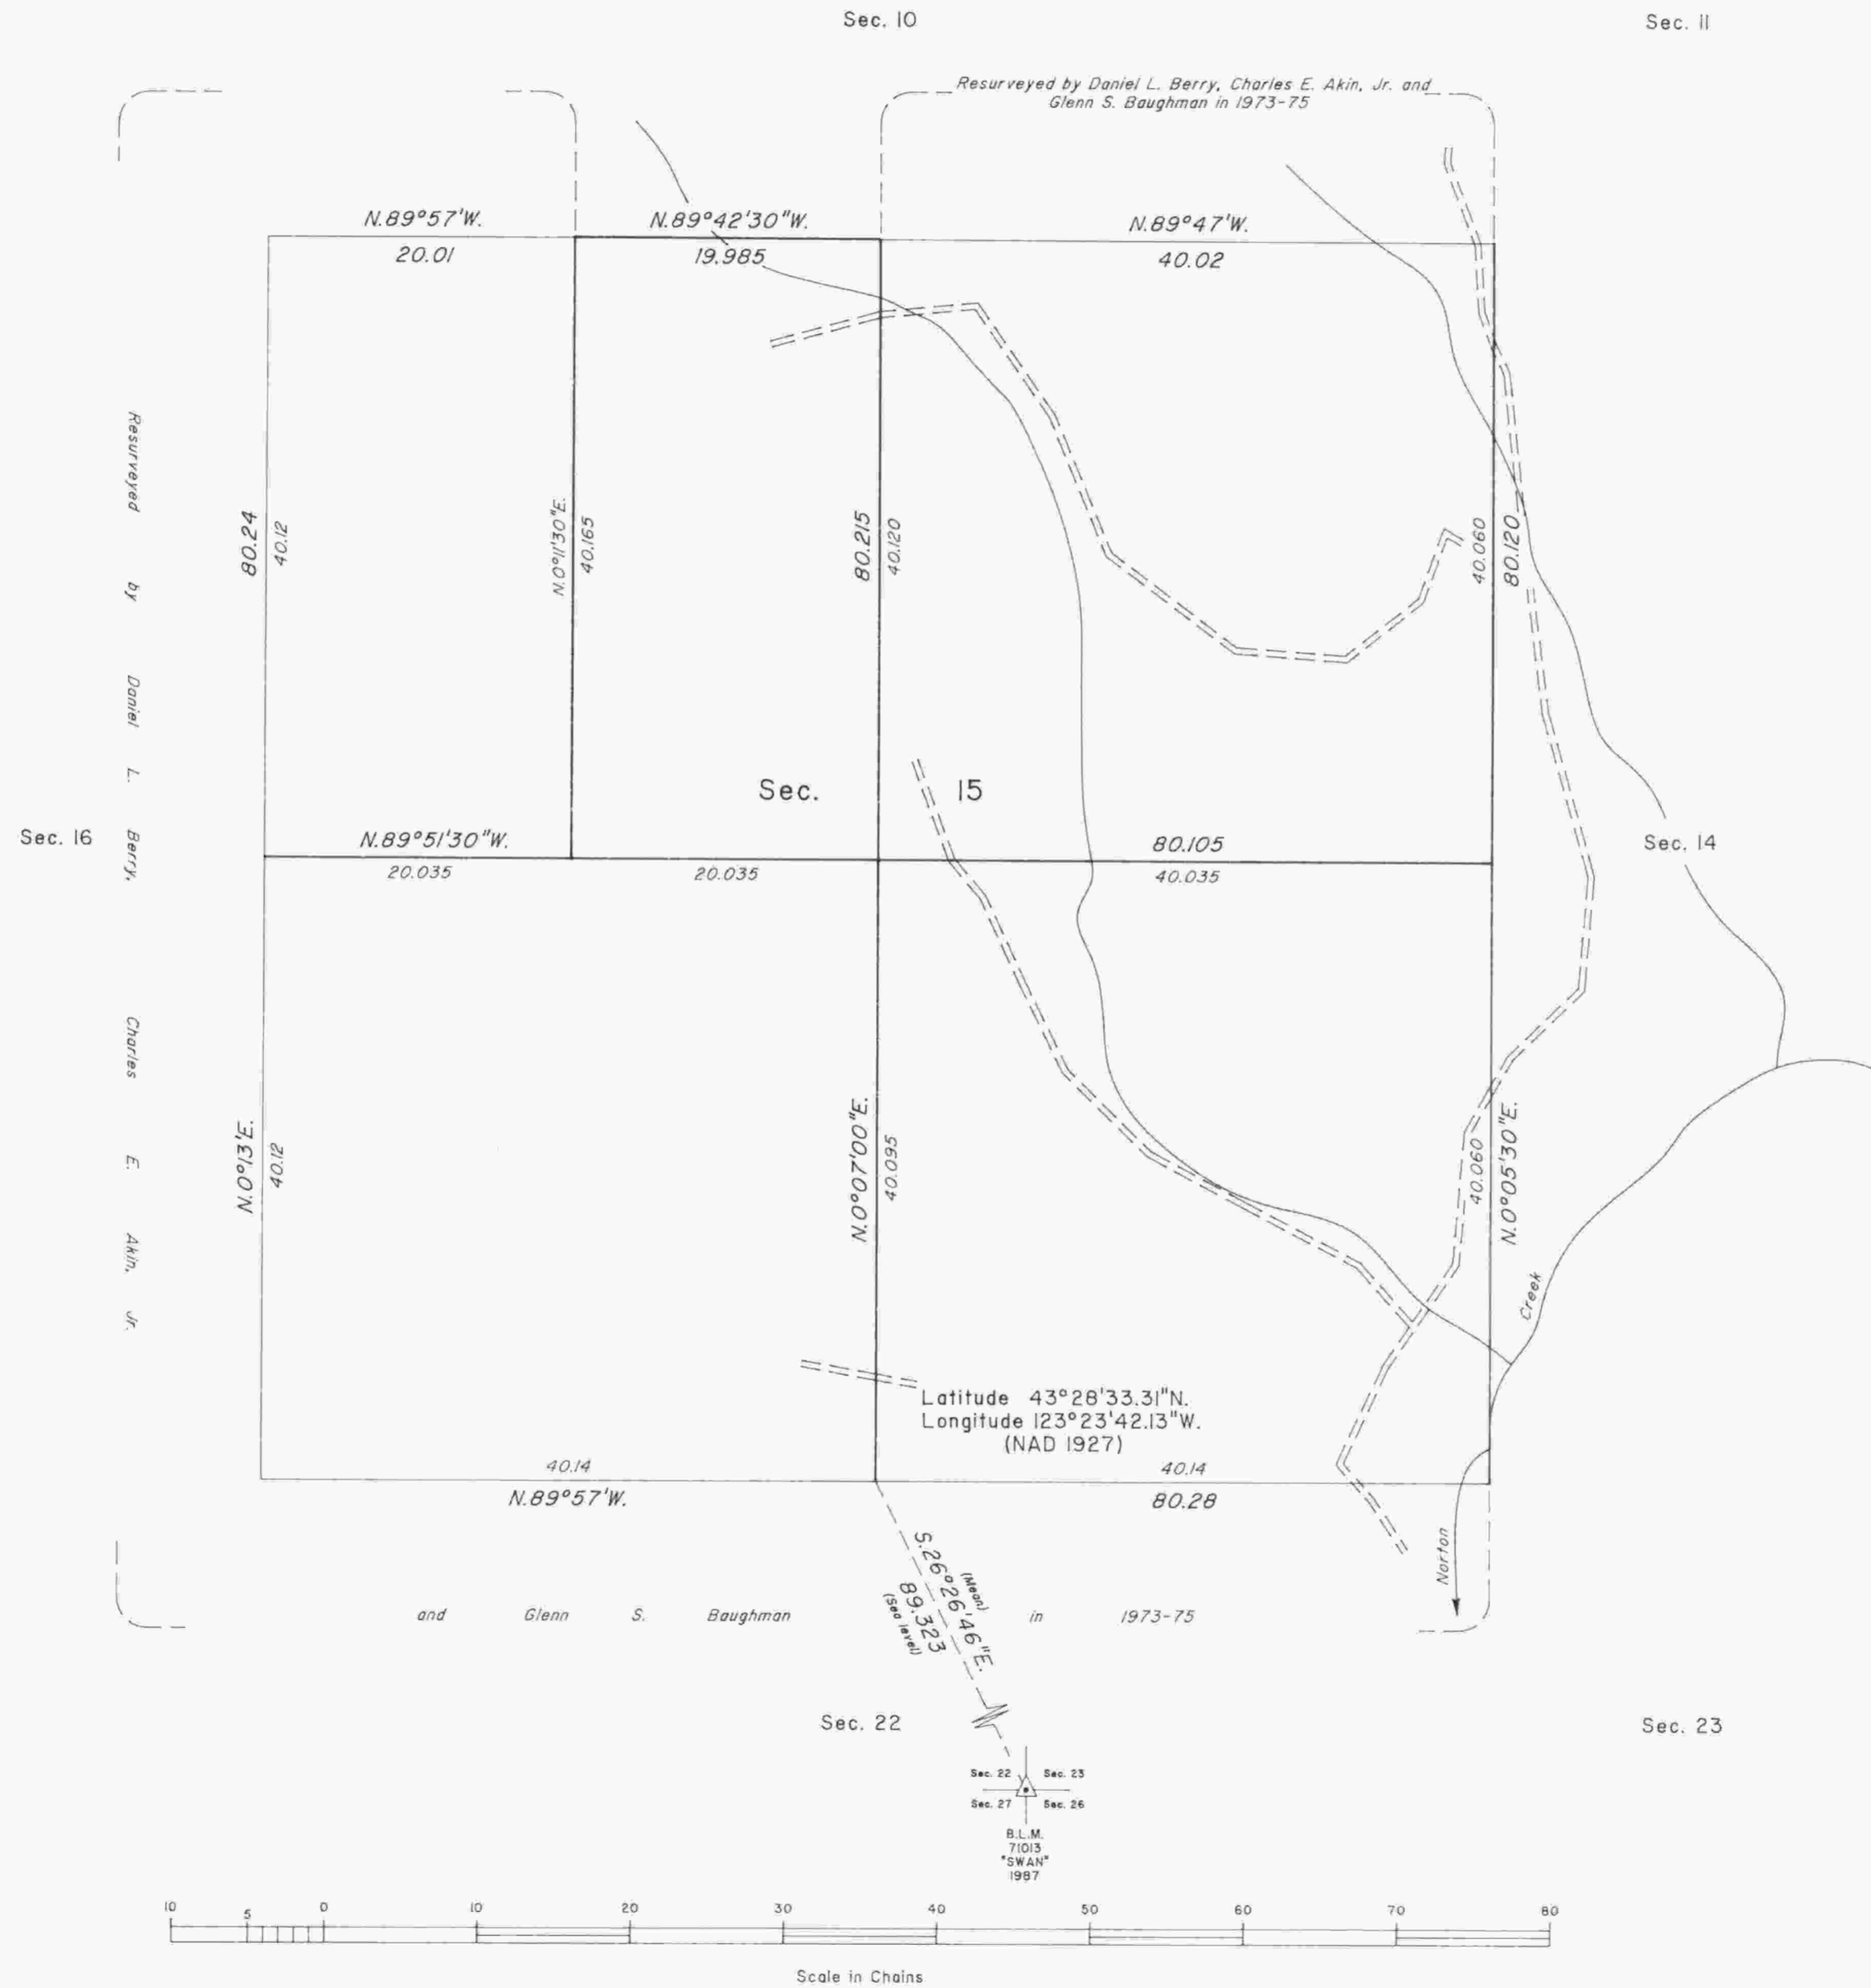

A history of surveys is contained in the field notes.

This plat represents a dependent resurvey of portion of the subdivisional lines, T. 24 S., R. 6 W., Willamette Meridian, Oregon, designed to restore the corners in their true original locations according to the best available evidence, and the subdivision of section 15.

The lottings and areas are as shown on the plat approved June 30, 1853.

The survey was executed by Wayne L. Rogers, Cadastral Surveyor, beginning September 5, 1991, and completed October 2, 1991, pursuant to Special Instructions dated July 30, 1991, under Group Number 1623, Oregon.

Timber in this area consists of fir, pine, alder maple, oak, willow, madrone, ash, dogwood, chinquapin, cedar and cherry.

The tie to the geodetic control station is reported as mean bearing and sea level distance.

UNITED STATES DEPARTMENT OF THE INTERIOR
BUREAU OF LAND MANAGEMENT

Portland, Oregon June 27, 1994

This plat is strictly conformable to the approved field notes, and the survey, having been correctly executed in accordance with the requirements of law and the regulations of this Bureau, is hereby accepted.

For the Director

Wayne M. Gardner
Chief Cadastral Surveyor of Oregon