


TOWNSHIP 24 SOUTH, RANGE 7 WEST, OF THE WILLAMETTE MERIDIAN, OREGON. DEPENDENT RESURVEY

(ARROW POINTING TO NORTH LINE)
VOID W.N.H.
(WILFORD HAINES)
S35 T23S R7W -
(SEE T23-7 PLAT APPROVED IN 1963)
SEE 1964 SURVEY CORRECTION

Sec. 35

Sec. 36


T.23S.,R.7 W.

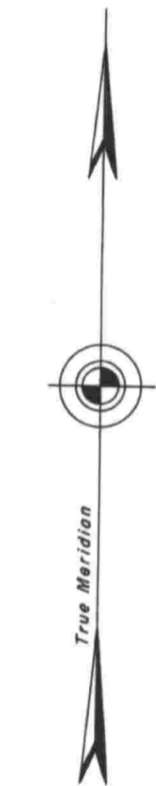

Mean magnetic declination
20° East


Sec. 2

(ARROW POINTING TO NORTH LINE)
VOID W.N.H.
(WILFORD HAINES)
S35 T23S R7W -
(SEE T23-7 PLAT APPROVED IN 1963)
SEE 1964 SURVEY CORRECTION

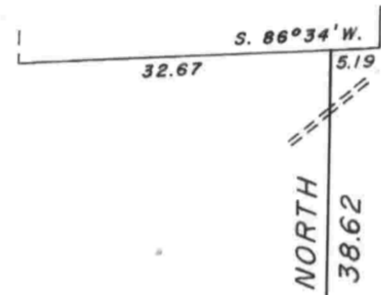

Latitude $43^{\circ}30\frac{1}{2}'$ N. Sec. 1
Longitude $123^{\circ}29'$ W.

T.24S.,R.7 W.

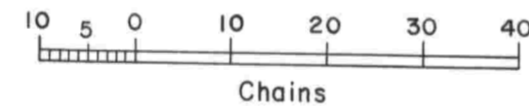

This plat represents a retracement and reestablishment of a portion of the subdivisinal lines designed to restore the corners in their true original location according to the best available evidence, and an extension of the original survey as shown by plat approved April 24, 1853 to complete the survey of the north half of the line between secs. 1 and 2.

Portion of subdivisinal lines surveyed by Dennis Hathorn in 1858.

Portion of the south boundary of T. 23 S., R. 7 W., surveyed by W. H. Byars in 1881.

Dependent resurvey and extension of the line between sections 1 and 2, T. 24 S., R. 7 W., Willamette Meridian, Oregon, executed by Joseph S. Gawron, June 11 to 17, 1958, under Special Instructions dated May 27, 1958, which provide for the surveys included under Group No. 405, Oregon.

Timber in this area consists of fir, hemlock, and cedar.

UNITED STATES DEPARTMENT OF THE INTERIOR
BUREAU OF LAND MANAGEMENT
Washington, D. C. June 1, 1960

This plat is strictly conformable to the approved field notes, and the survey, having been correctly executed in accordance with the requirements of law and the regulations of this Bureau, is hereby accepted.

For the Director

Cadastral Engineering Staff Officer