

# TOWNSHIP 26 SOUTH, RANGE 7 WEST, OF THE WILLAMETTE MERIDIAN, OREGON

DOUGLAS COUNTY  
SURVEYOR

## RETRACEMENT

This plat represents the entire survey record of the retracement of a portion of the subdivisional lines, T. 26 S., R. 7 W., Willamette Meridian, Oregon.

The history of surveys pertaining to this retracement is as follows:

In 1855, Dennis Hathorn, U.S. Deputy Surveyor, surveyed the north, south, and west boundaries and a portion of the subdivisional lines.

In 1881, Addison R. and Samuel C. Flint, U.S. Deputy Surveyors, retraced the west boundary and portions of the north and south boundaries, and completed the subdivisional lines.

In 1959, Irving Zirpel, Jr. and Leo J. Martin, Cadastral Surveyors, dependently resurveyed a portion of the west boundary and the subdivisional lines.

In 1969, Lynn M. Roseberry, Cadastral Surveyor, dependently resurveyed a portion of the subdivisional lines.

In 1971-74, Peter A. Peterson, Daniel L. Berry, Gurdon S. Popken, and Harvey E. Wofford, Cadastral Surveyors, dependently resurveyed a portion of the south boundary and a portion of the subdivisional lines.

In 2001-02, Timothy J. Moore, Cadastral Surveyor and Robert H. Browning, Surveying Technician, dependently resurveyed a portion of the south boundary and subdivisional lines and subdivided sections 21 and 32.

The survey was executed in accordance with the specifications set forth in the Manual of Surveying Instructions, 1973. The retracement data were thoroughly verified and only the true line data is given hereon. Only those lines bounding or crossing public lands were blazed. The directions of the lines were determined by direct solar observation, carried forward by sustained angulation, and refer to the true meridian.

An analysis of the unadjusted field data assured a closure not exceeding 1:4000 in error. The measured distance and direction have been adjusted by computer software that incorporates a least squares adjustment routine. The adjusted bearing and distance are reported to the nearest second and 0.01 foot.

The geographic position shown hereon was determined by differentially corrected carrier phase GPS receivers relative to the National Spatial Reference System.

This retracement was executed by Timothy J. Moore, Cadastral Surveyor, and Robert H. Browning, Surveying Technician, beginning June 28, 2006 and completed June 24, 2006; pursuant to Assignment Instructions dated June 28, 2006, under Special Instructions for Group Number 2100, Oregon, dated and approved March 8, 2004; and Instructions to Cancel Group 2100 and Reassign to Group 2300, dated October 12, 2007, under Group Number 2300, Oregon, Administrative File Number 0607, dated March 16, 2007, approved March 21, 2007.

UNITED STATES DEPARTMENT OF THE INTERIOR  
BUREAU OF LAND MANAGEMENT

Portland, Oregon

The retracement represented by this plat, having been correctly executed in accordance with the requirements of law and the regulations of this Bureau, is hereby accepted.

For the Director

*Mary J. M. Hunt*

Chief Cadastral Surveyor of Oregon

*March 18, 2011*

Date

Described by Moore and Browning in 2001-02. 1/4 Cor. Sec. 31 Sec. 32

Described by Peterson, et al, in 1971-74. Sec. 31 Sec. 32 T. 26 S. Sec. 6 Sec. 5 T. 27 S.

Latitude 43°15'28.10"N.  
Longitude 123°33'54.48"W.  
(NAD 1983 (CORS 96))

N. 0°37'20"E.  
2637.88'



We, Timothy J. Moore, Cadastral Surveyor, and Robert H. Browning, Surveying Technician, HEREBY CERTIFY upon honor, that in pursuance of Special Instructions bearing date of the 8th day of March, 2004, and the 16th day of March, 2007, have retraced a portion of the subdivisional lines, Township 26 South, Range 7 West, Willamette Meridian, Oregon. Said retracement has been executed in strict conformity with said Special Instructions, the Manual of Instructions for the Survey of the Public Lands of the United States, 1973, and in specific manner described on this plat.


*Timothy J. Moore*  
Cadastral Surveyor

*March 3, 2011*  
Date

*Robert H. Browning*  
Surveying Technician

*March 16, 2011*  
Date

**LEGEND**  
◇ Original corner previously remonumented  
□ Corner previously reestablished

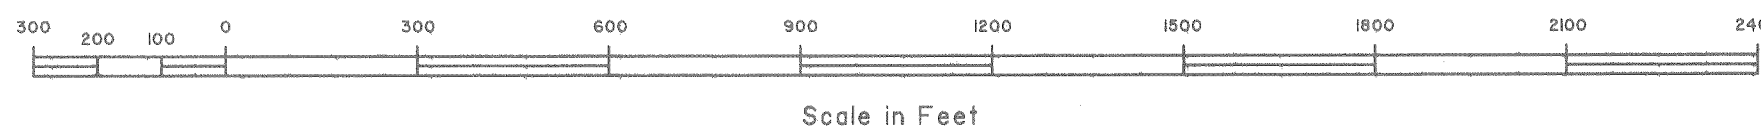

OFFICIALLY FILED: 5/14/2011