


Township N° 27 South Range N° 5 West Willamette Meridian.

678

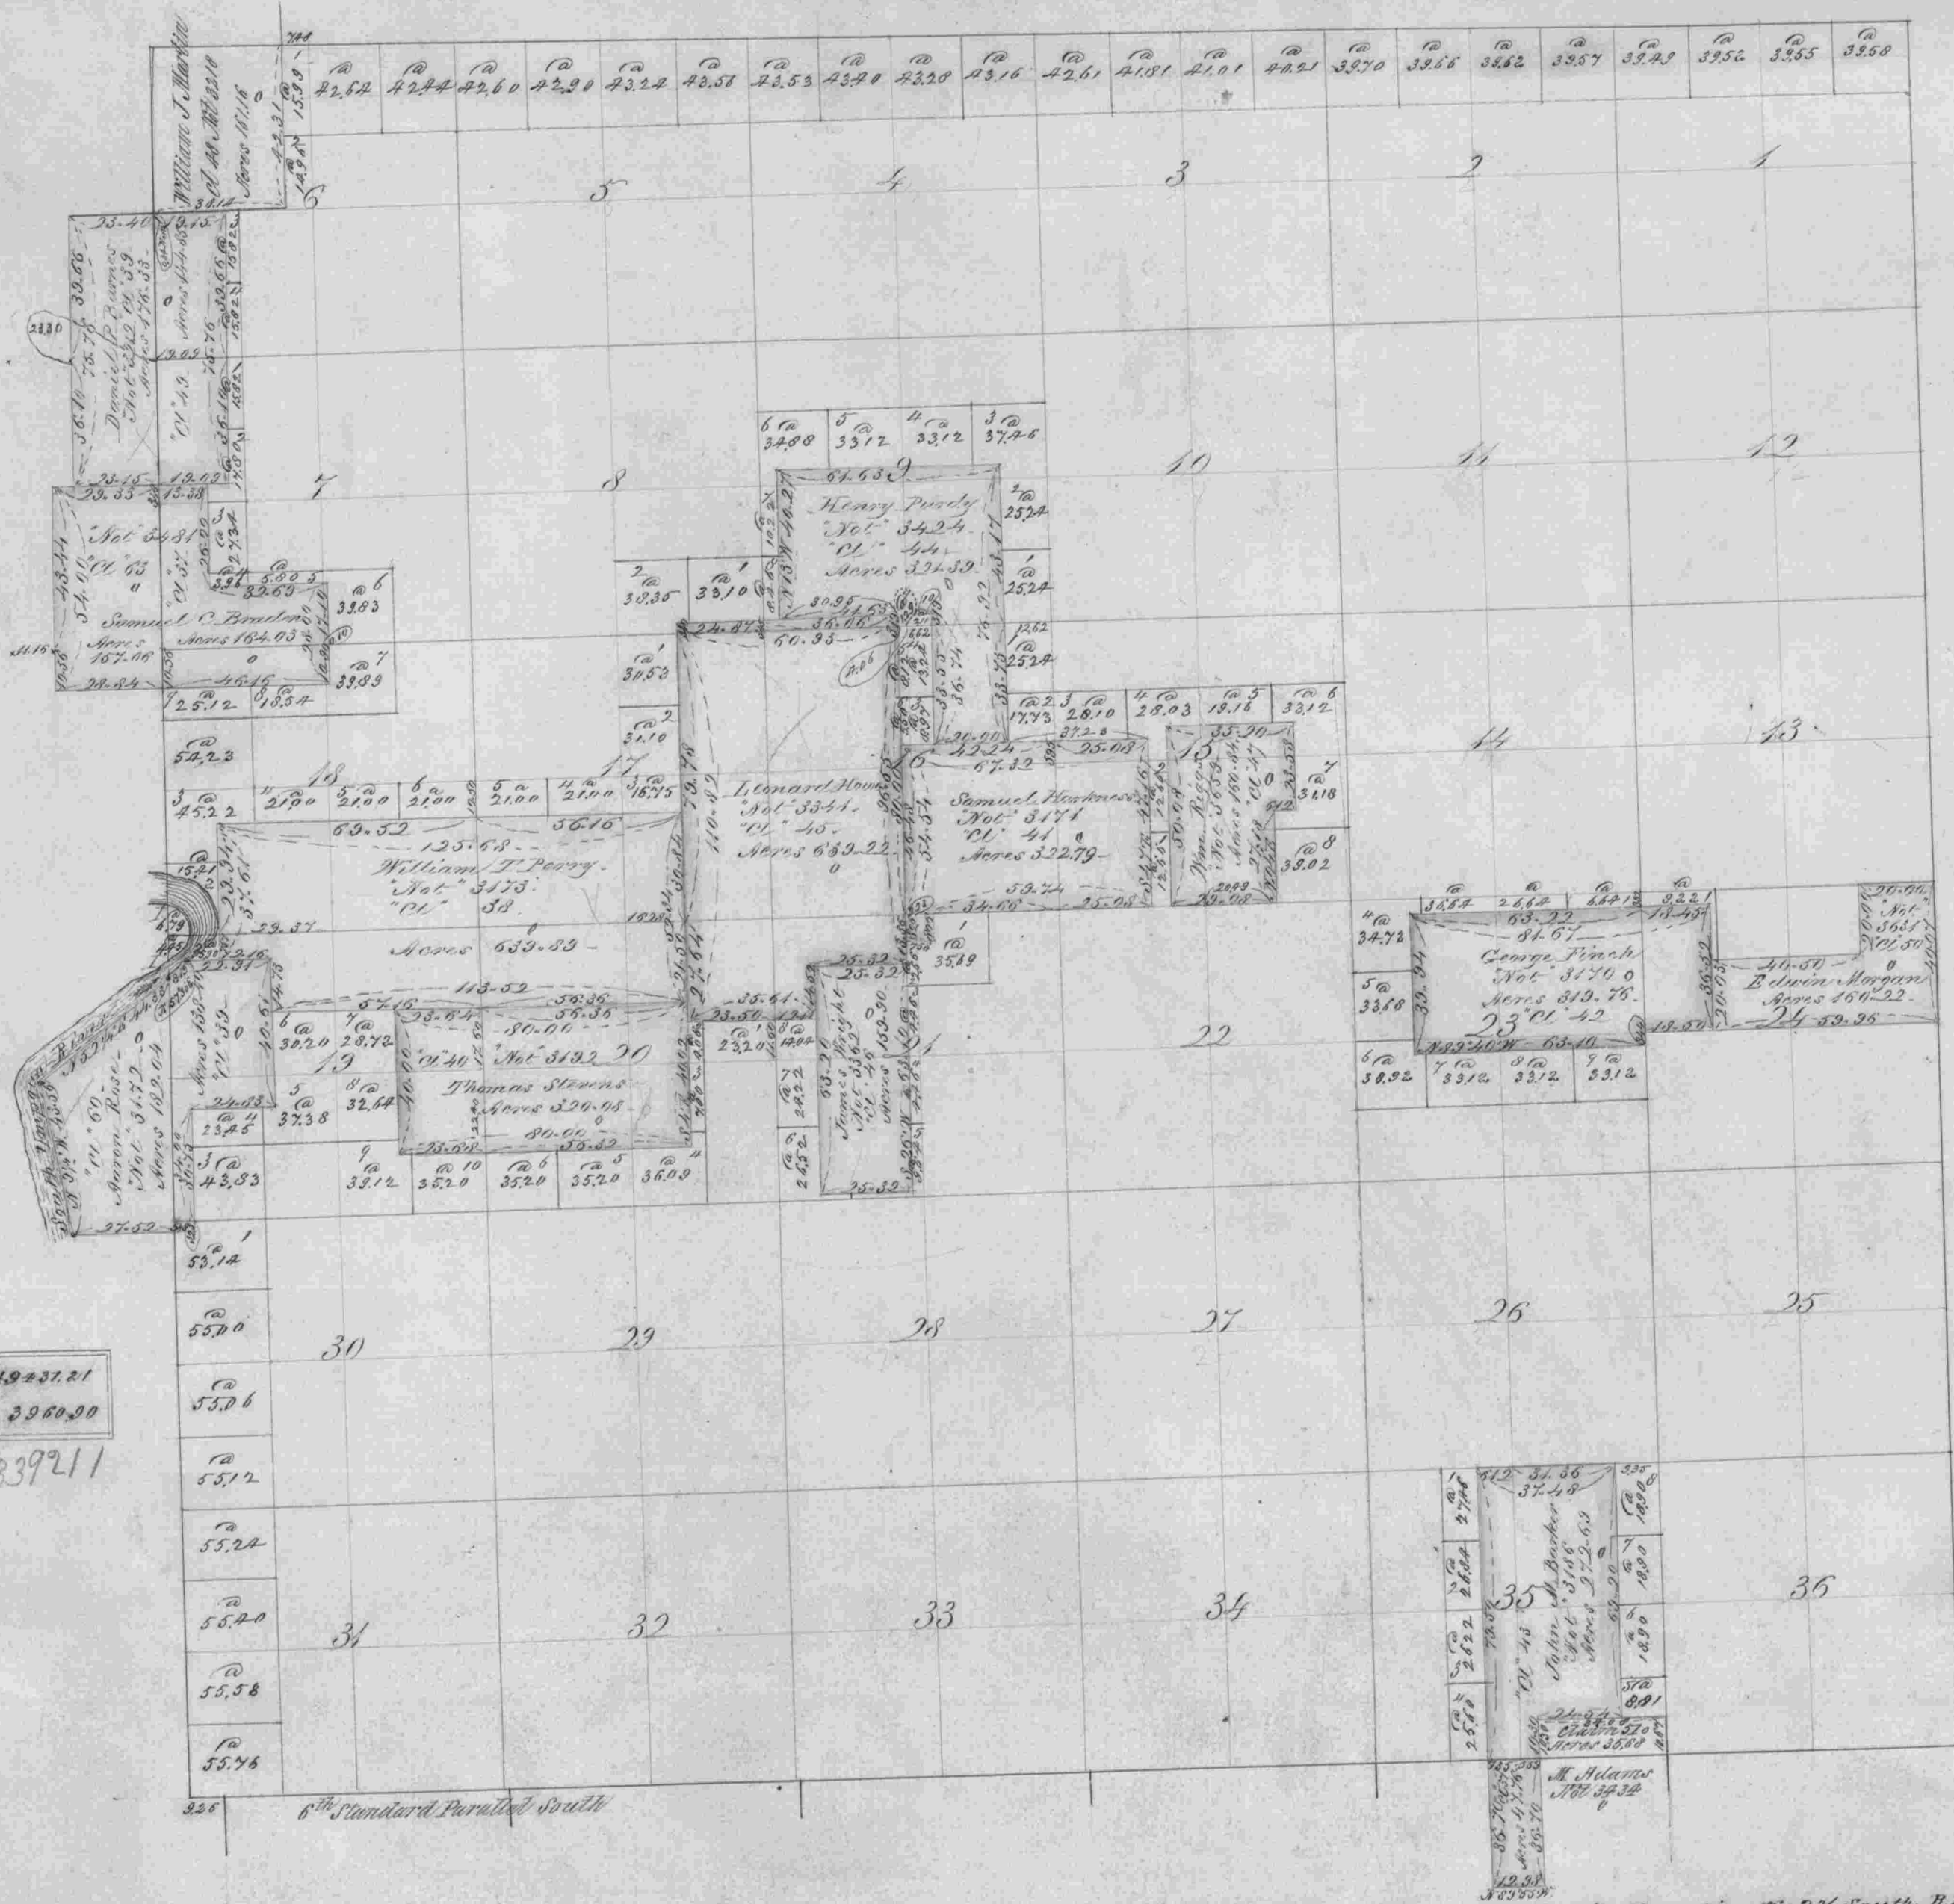

Aggregate Area of Public Lands 19237.21
Private Surveys 2960.20

23392.11

The above Map of the Survey of Claims in Township N° 27 South Range N° 5 West of the Willamette Meridian Oregon is strictly conformable to the field notes of the Surveys thereof on file in this Office which have been examined and Approved.
Surveyor Gen.'s Office
Eugene City Bldg. 2nd 1860.

A. H. Chapman
Sur. Gen. May 27