


Township 28 South Range 5 West
28

General Description
 Principally high and abrupt mountains separated by deep canyons with a dense growth of Fir pine and cedar timber alternating on the south slopes - Canyons are deep and brushy

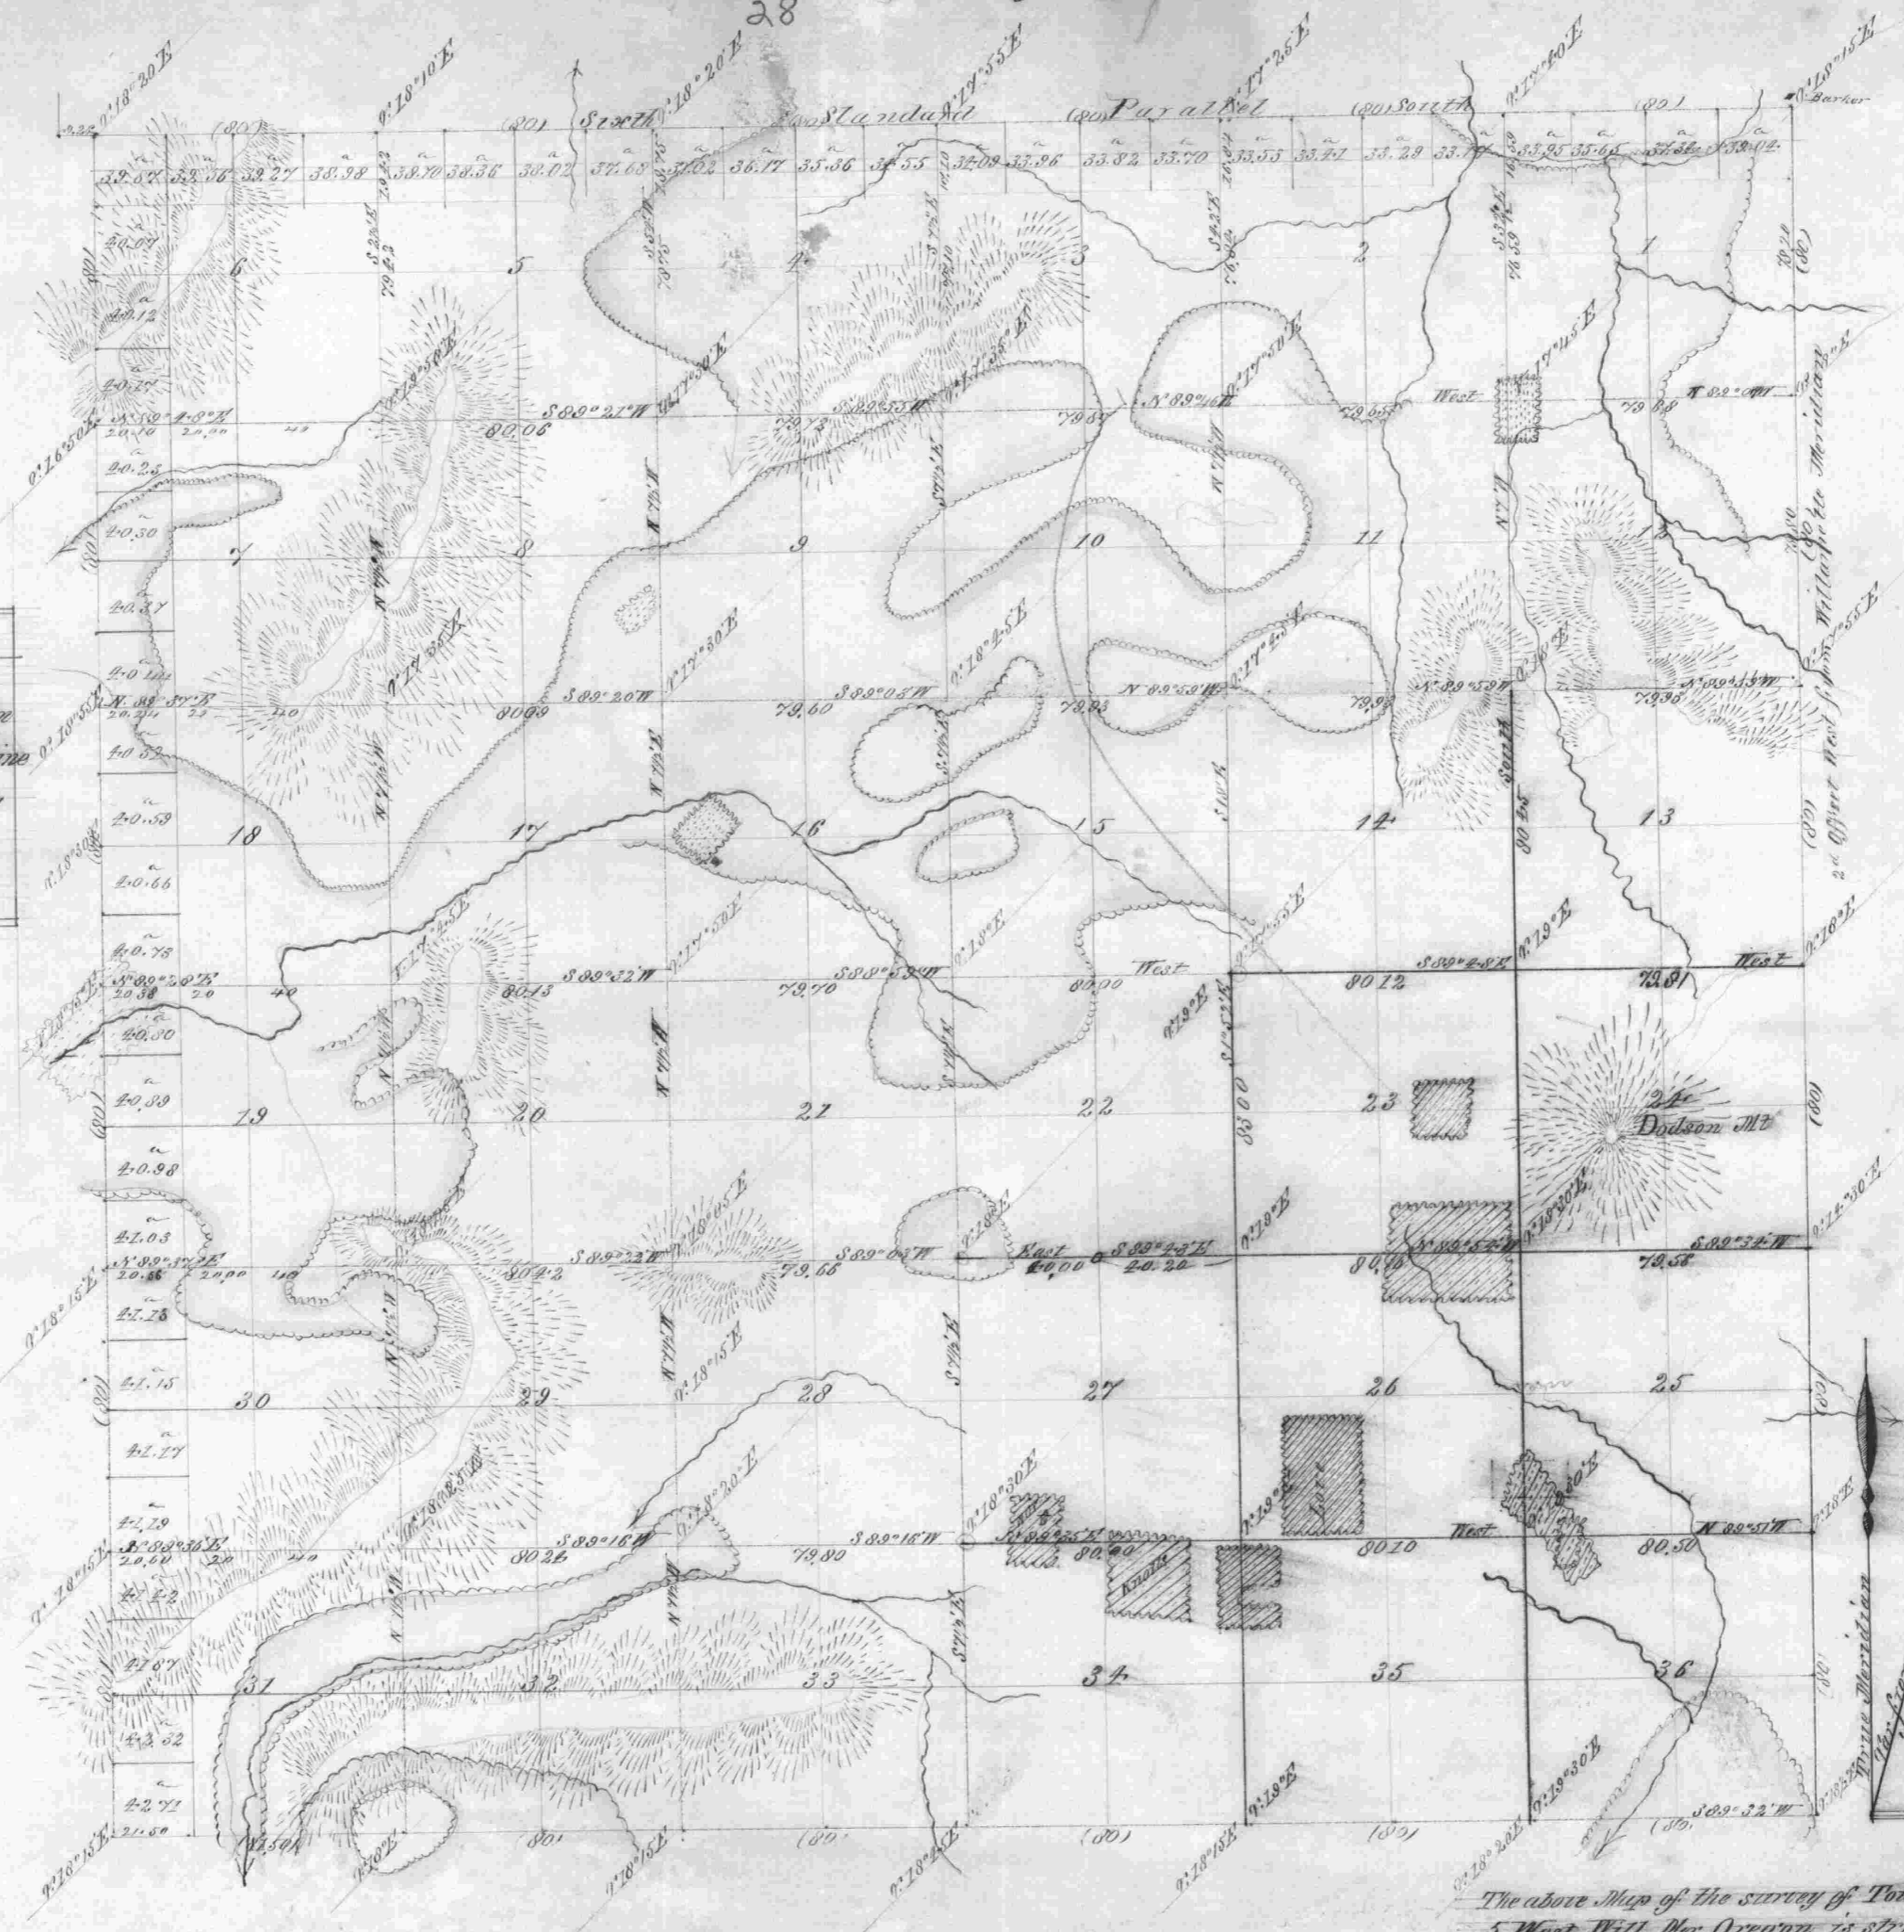

Sections	Acres
13	640.00
14	640.00
23	640.00
24	640.00
25	640.00
26	640.00
27	640.00
28	640.00
29	640.00
30	640.00
31	640.00
Total	6400.00

Survey of old survey not given

Lines	Contractor	Contract		Amount Surveyed		Commenced	Completed
		No	Date	Miles	Chains Links		
Subdivisions	Flint & Williams	151	May 23 rd 1871	14	443 50	July 18 1871	July 25 1871

Blue lines indicate old survey

The above Map of the survey of Township 28 South Range 5 West Will Mer Oregon is strictly conformable to the original field notes of the survey thereof on file in this Office which have been examined and approved
 Surveyor General's Office
 Eugene City Feb 26th 1872
 W. H. Hall
 Sur Gen

Scale 40 Chains to an inch