


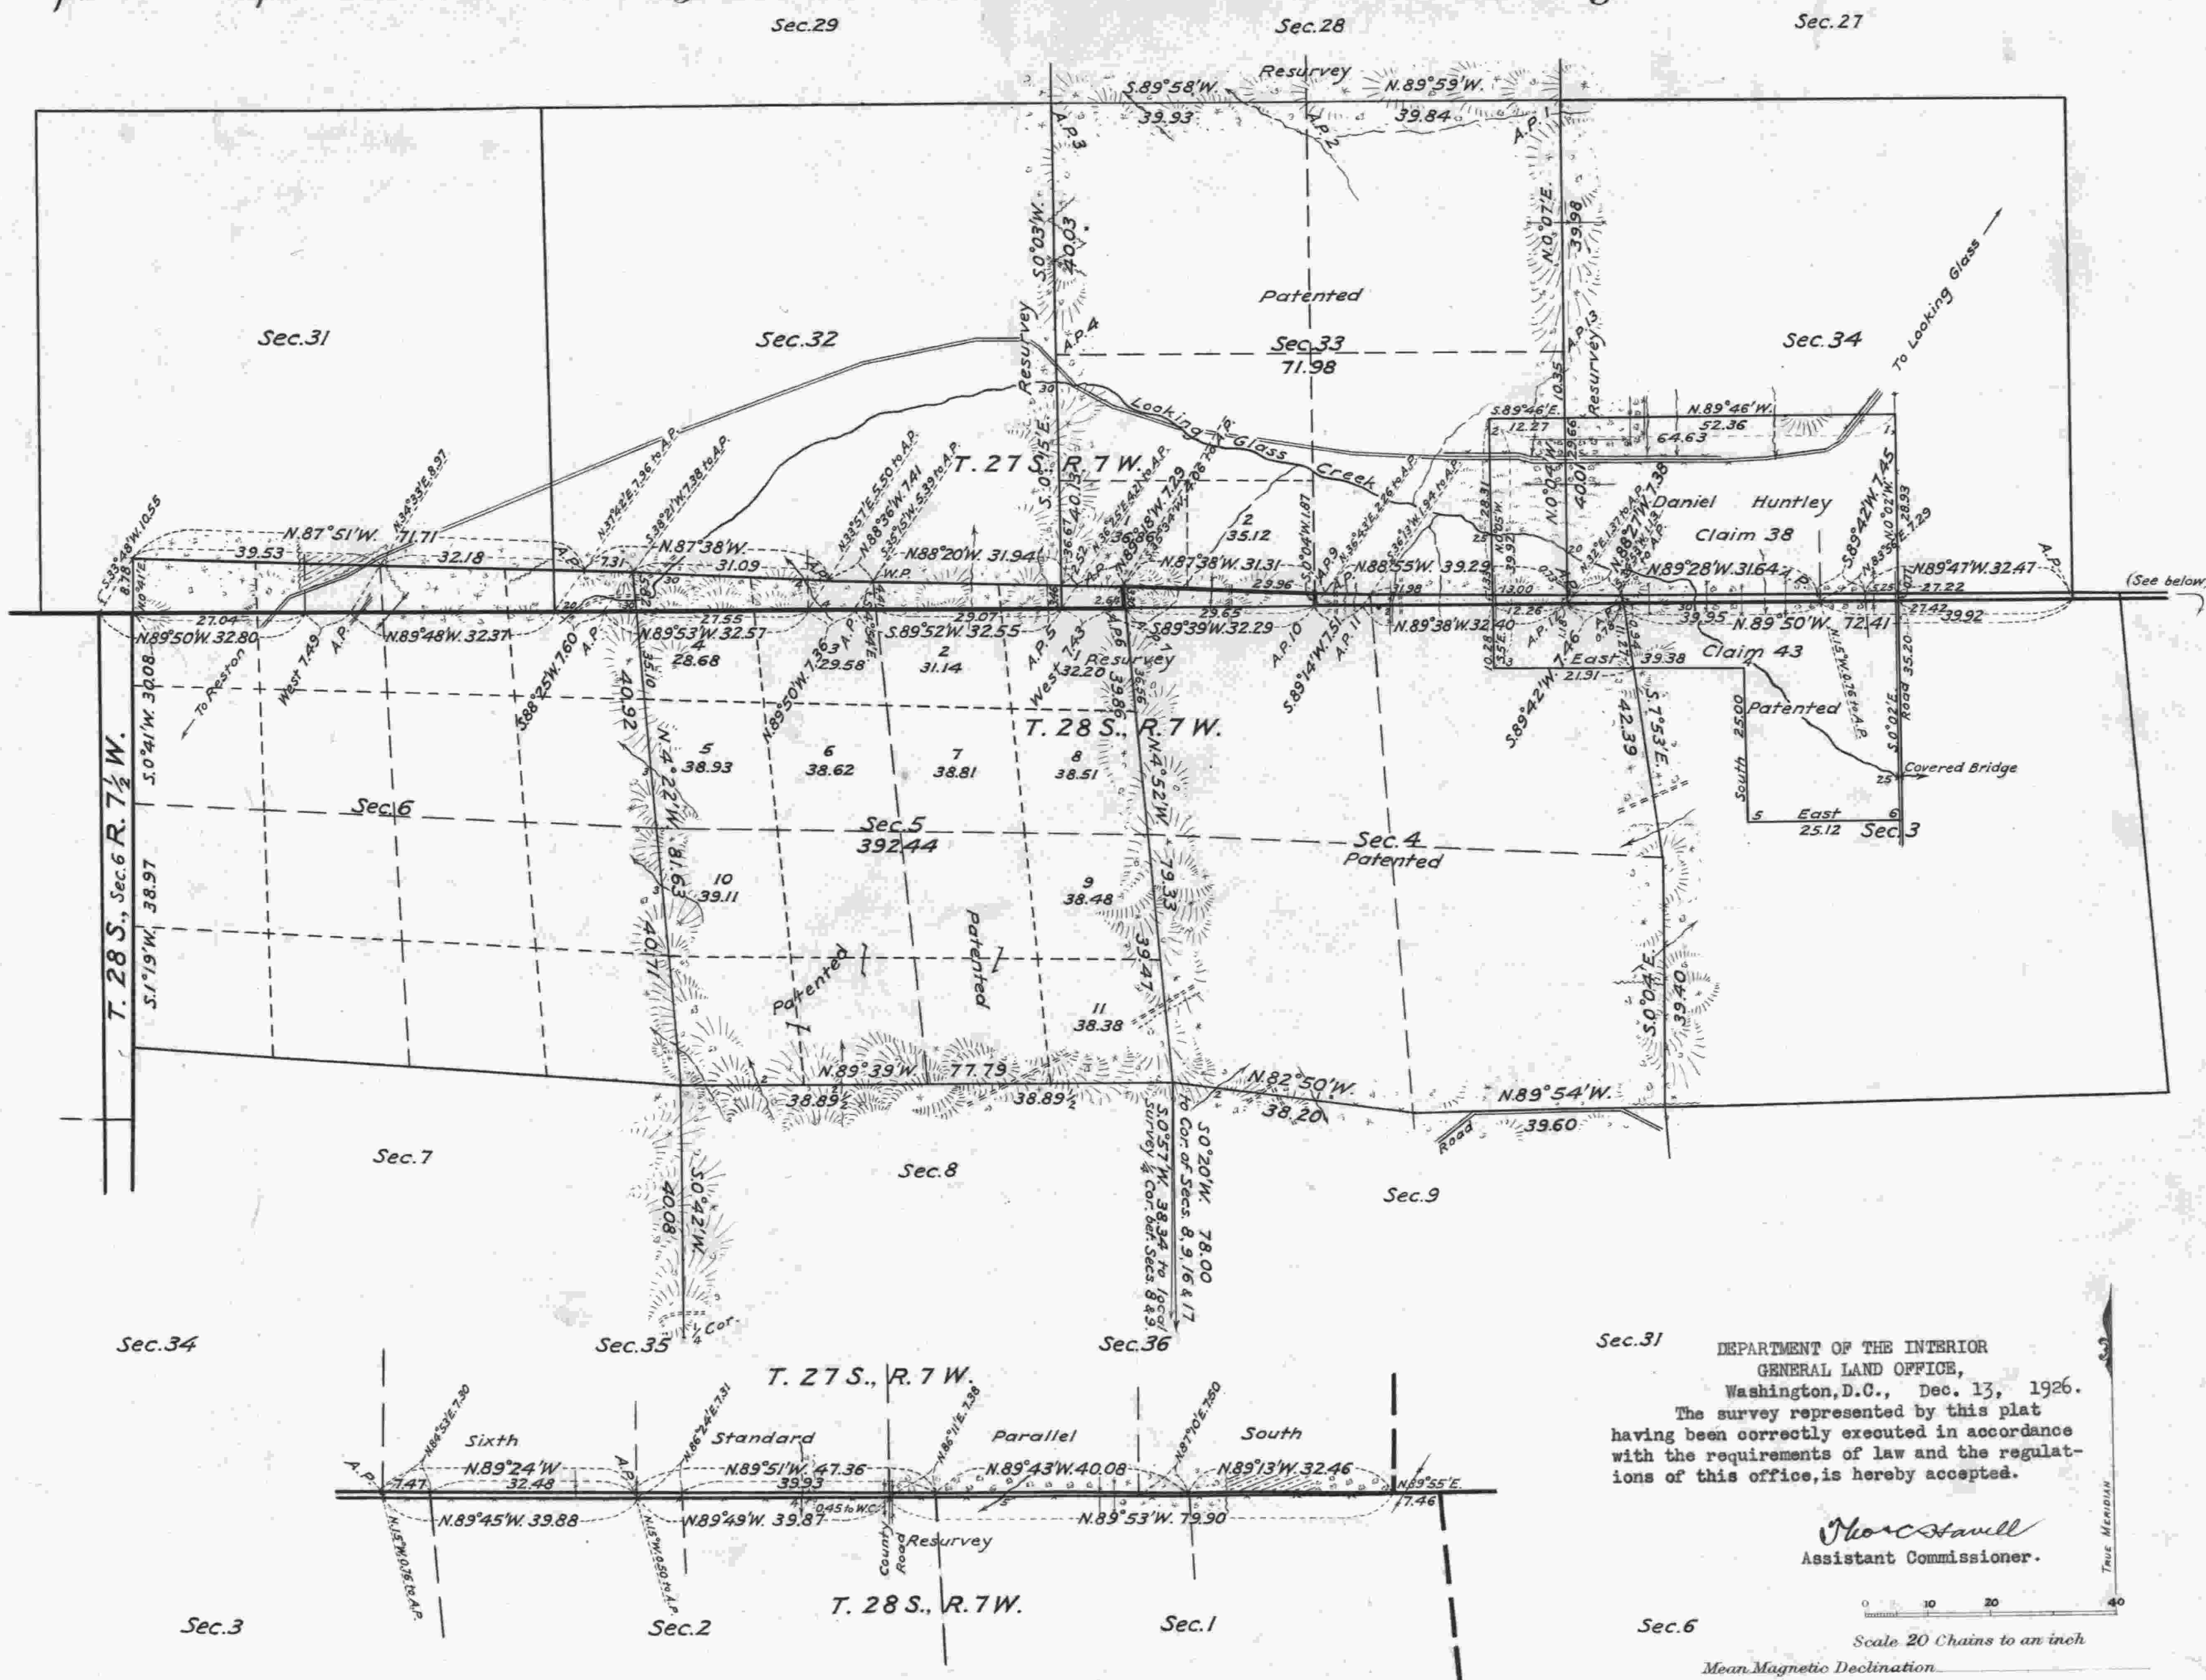

Overlap in
The above map of Townships Nos. 27 & 28 South, Range No. 7 West of the Willamette
Meridian, Oregon, is strictly conformable to the field notes of the survey thereof
which have been examined and approved.

Office of U.S. Supervisor of Surveys,
Denver Colorado, Feb. 15, 1926.

Franklin Johnson
U. S. Supervisor of Surveys.