
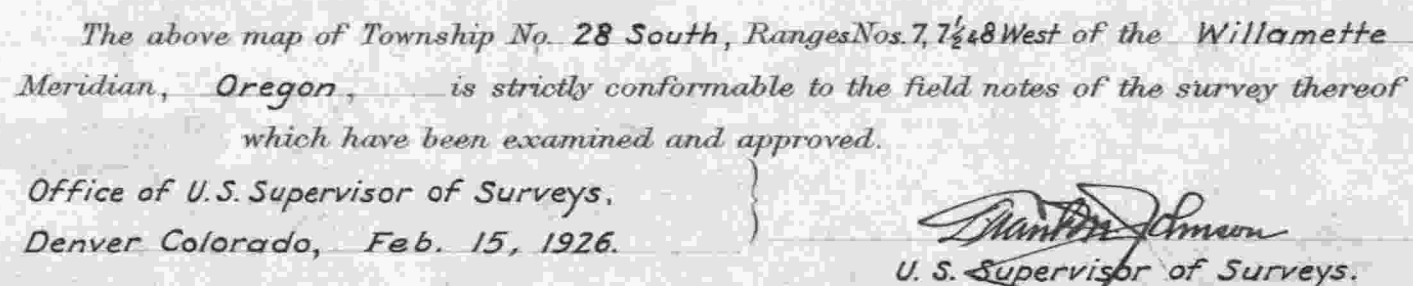


T. 28 S., R. 7½ W.

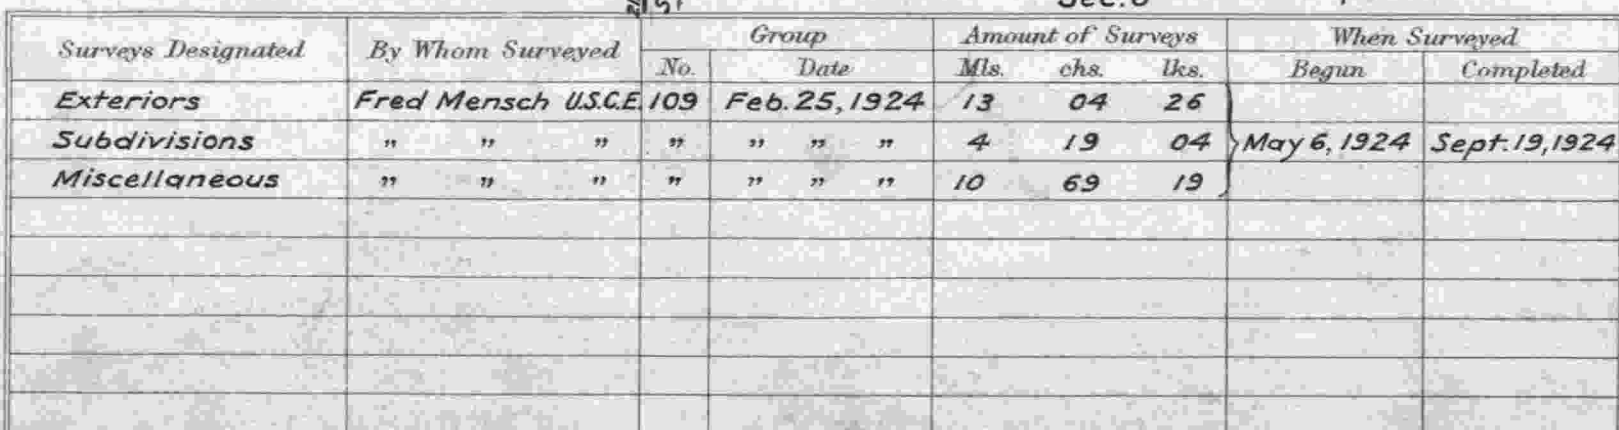

4554