

TOWNSHIP 29 SOUTH, RANGE 4 WEST, OF THE WILLAMETTE MERIDIAN, OREGON.
DEPENDENT RESURVEY

This plat represents a retracement and reestablishment of the line between sections 12 and 13, designed to restore the corners in their true original locations according to the best available evidence based upon the plats approved March 9, 1855, and August 11, 1881.


A portion of the subdivisional lines were surveyed by Nathaniel Ford in 1855. In 1881, William H. Byars retraced a portion of the subdivisional lines and completed the survey of the remaining subdivisional lines of the township.

These surveys executed by Donald R. Beck, September 2 to September 9, 1964, under Special Instructions dated July 12, 1940, which provide for the surveys included under Group No. 255, Oregon.

T.29 S., R. 3 W.



Mean
Magnetic
Declination
20°00' East

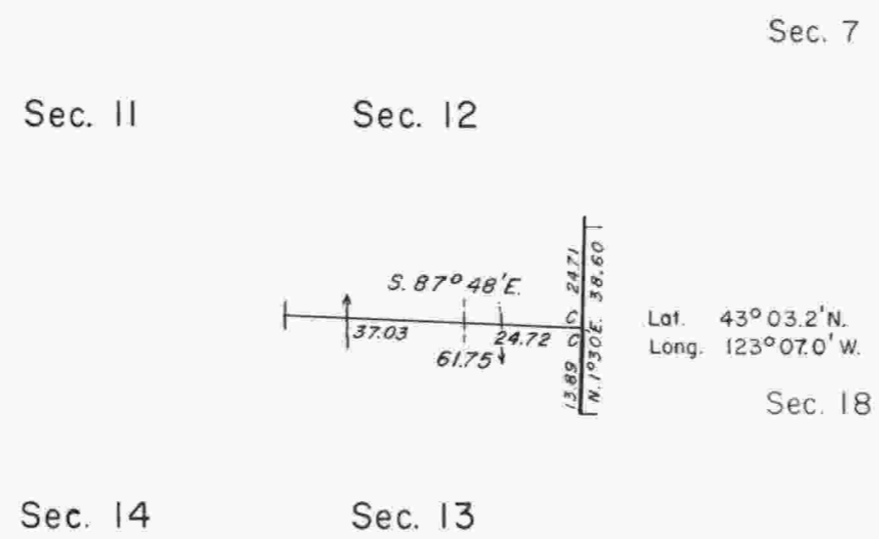

Timber in this area consists of Douglas fir, white fir, hemlock, cedar, maple, madrone, alder, yew, and dogwood.

UNITED STATES DEPARTMENT OF THE INTERIOR
BUREAU OF LAND MANAGEMENT
Washington, D. C. December 16, 1966

This plat is strictly conformable to the approved field notes, and the survey, having been correctly executed in accordance with the requirements of law and the regulations of this Bureau, is hereby accepted.

For the Director

Clark J. Lumm

Acting Chief, Division of Engineering