


Township No 29 South Range No 7 West Willamette Meridian.

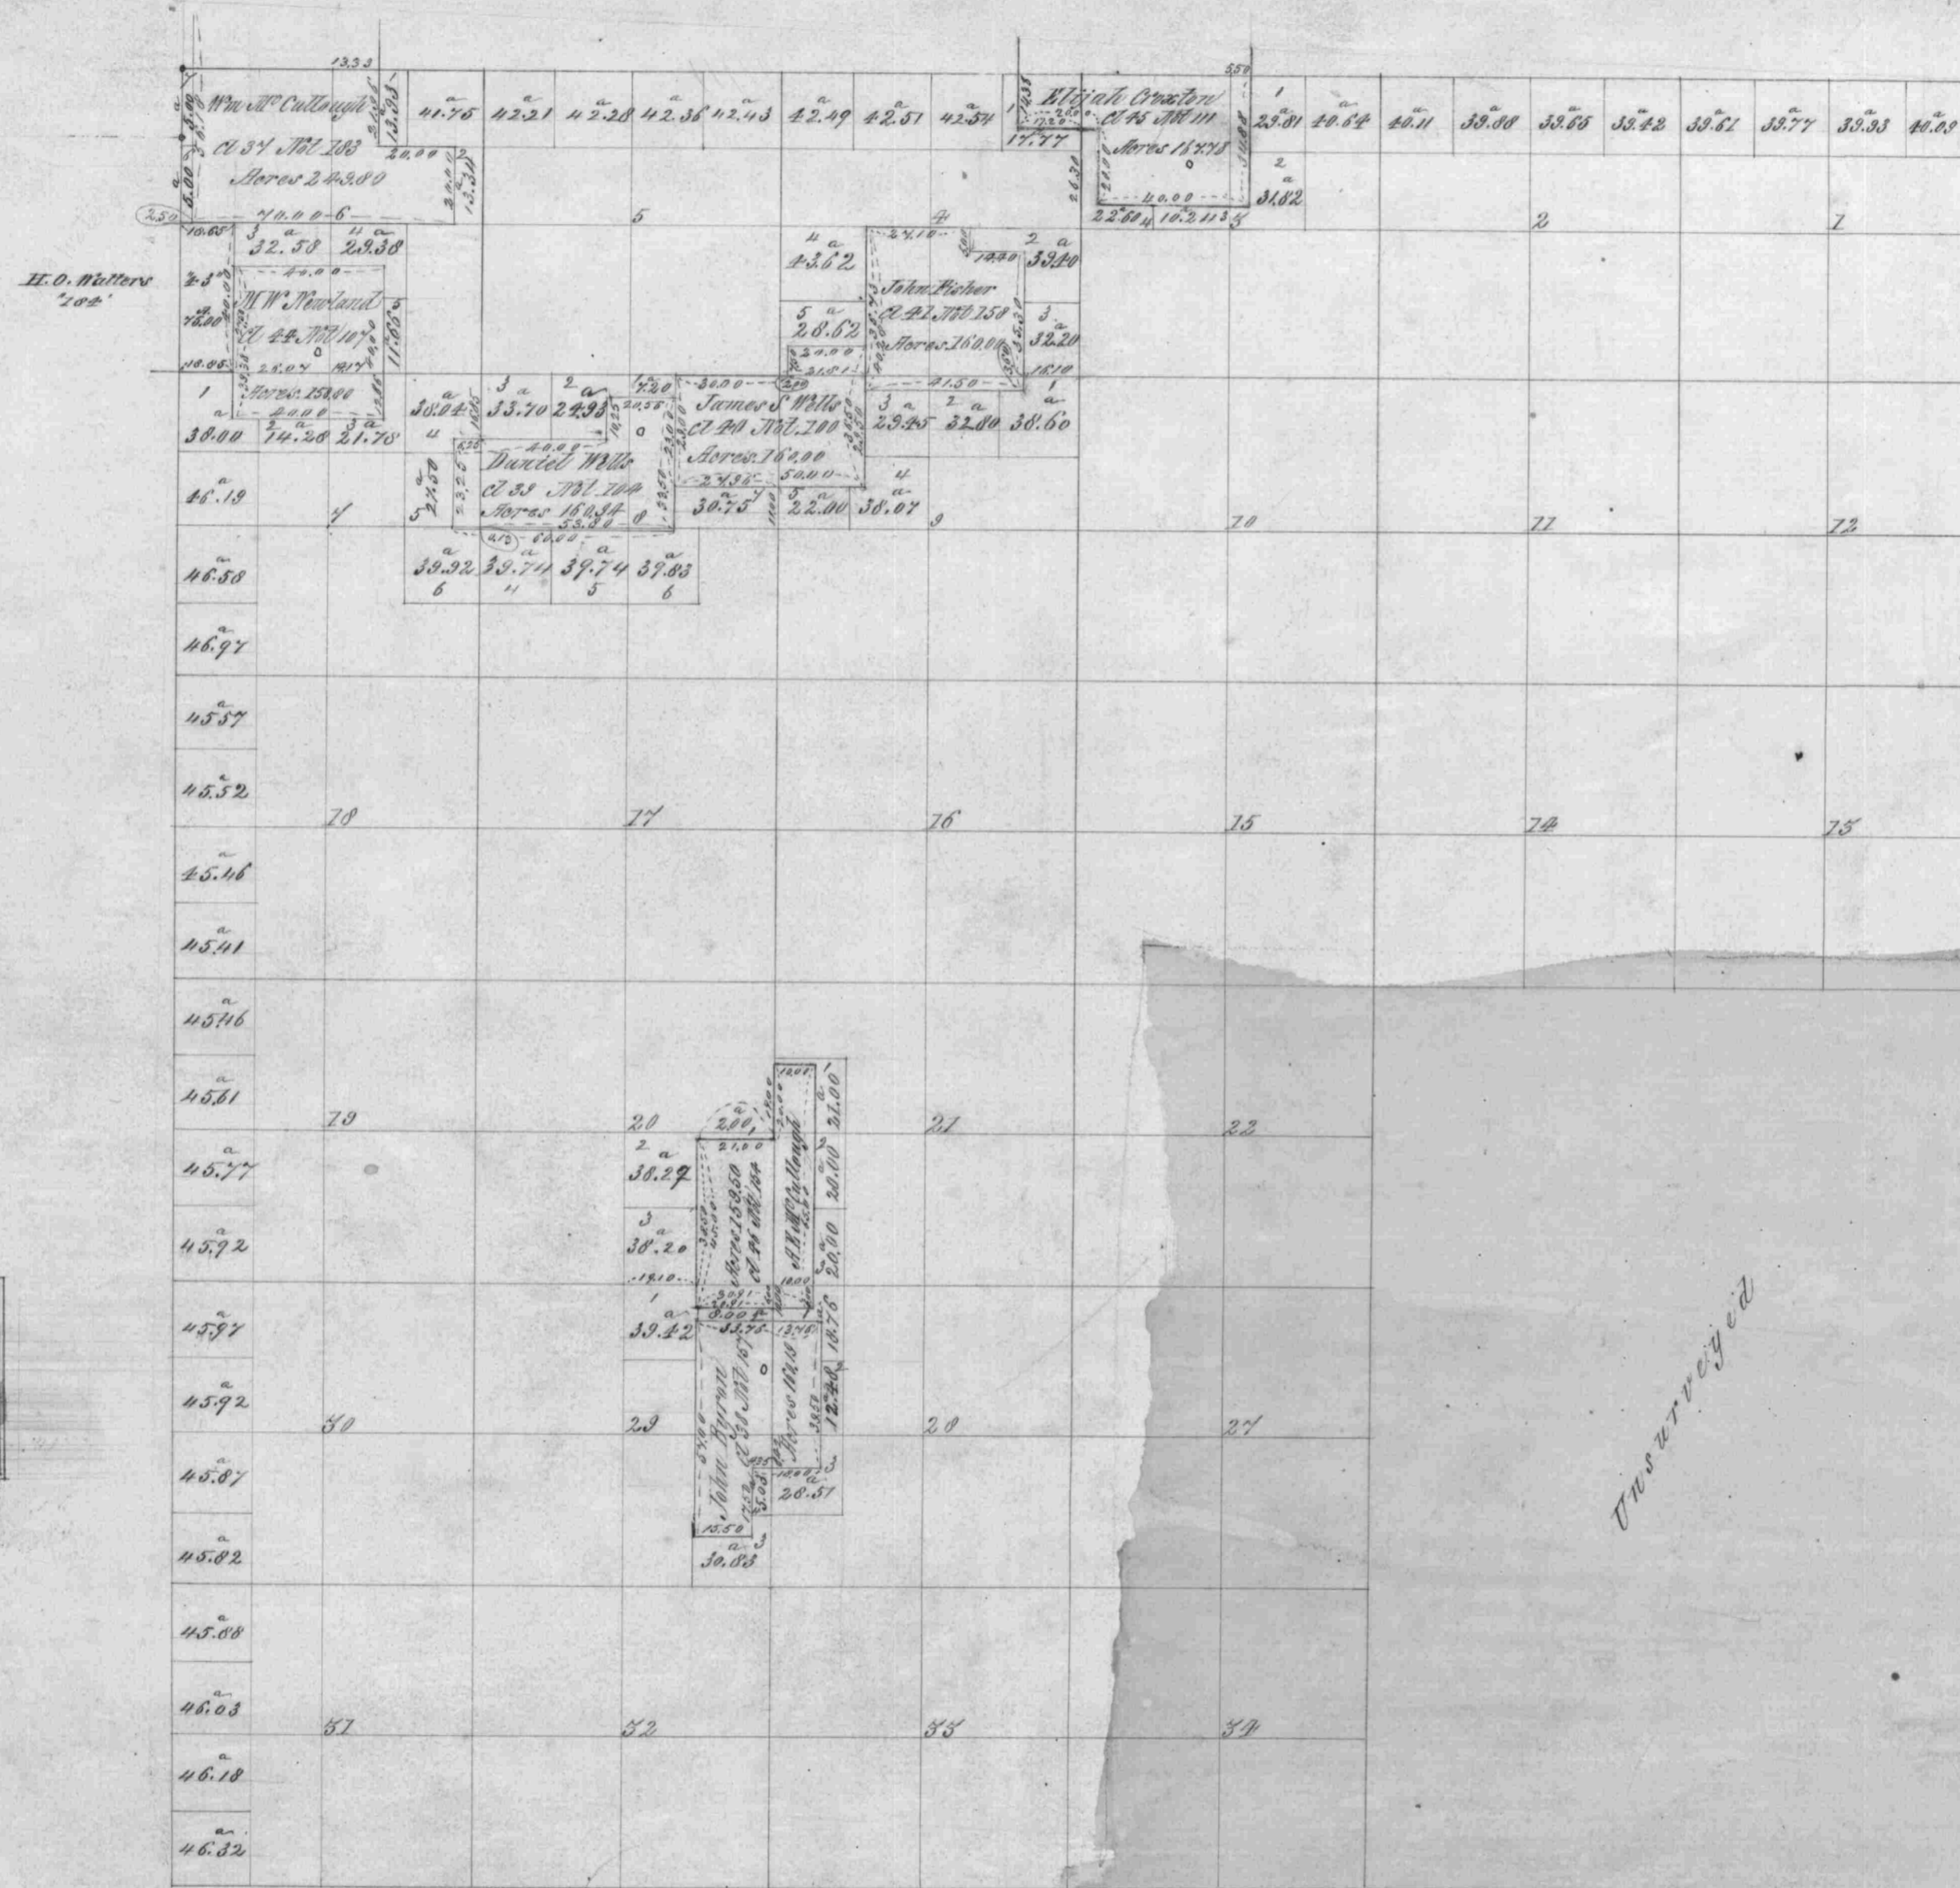

Legal Sub. Dem. Cts.	
Surveyed	1452.01
Pub. Ld. remaining	
Total on Ct. map	19351.25
Diff. of computation	21.85
Total on the plat	19373.10

The above Map of the survey of claims in T. 29 S. R. 7 W. Will. Mer. Agr. is strictly conformable to the field notes of the survey thereof on file in this office, which have been examined and approved.

B. J. Bressa  
Supt. Gen. Off. Oregon.