


TOWNSHIP 29 SOUTH, RANGE 8 WEST, OF THE WILLAMETTE MERIDIAN, OREGON

FILED
 Date: 6/3/2008 By: JC
 This survey consists of:
 Map: COPY OF MAP IN BLM VOL. 55
 Section: _____
 General Plat: PAGE 21464
 DOUGLAS COUNTY
 SURVEYOR

RETRACEMENT

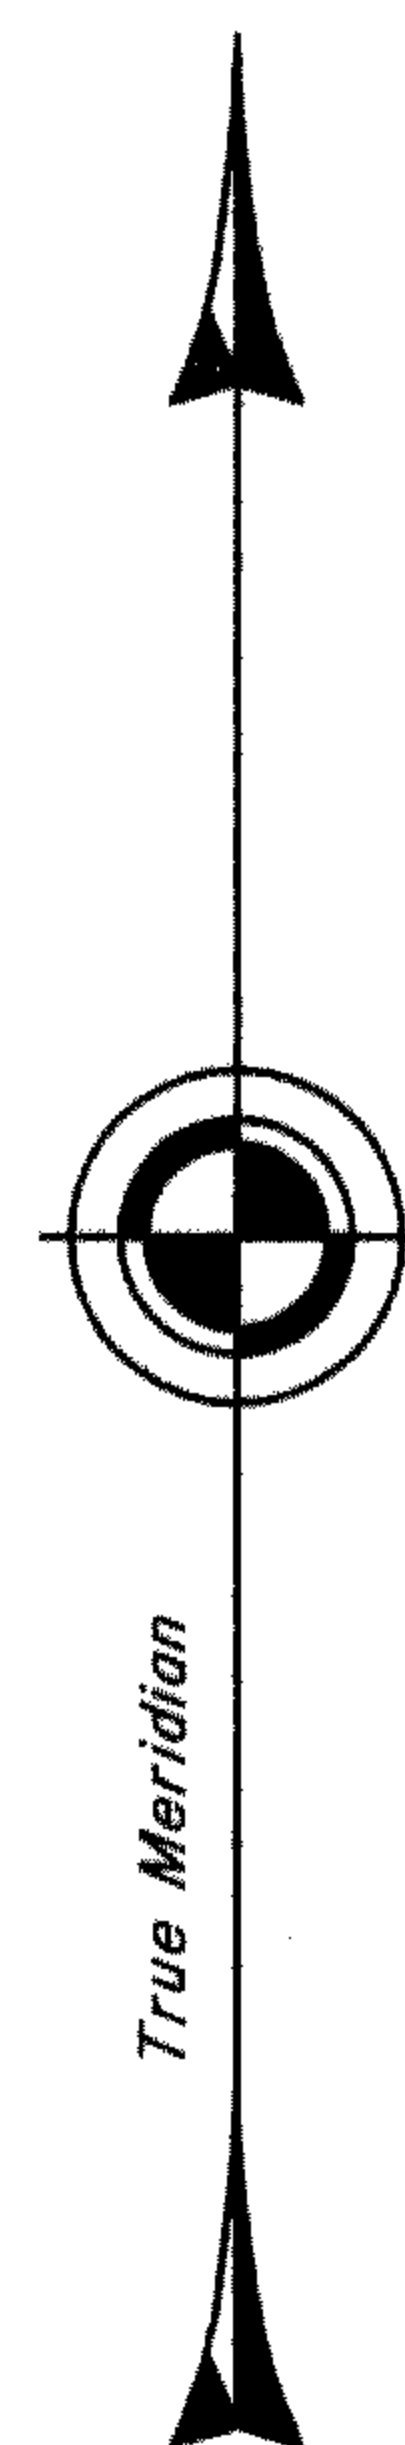

Sec. 29

Sec. 28



LEGEND
 ◊ Original corner previously remonumented

This plat represents the entire record of the retracement of a portion of the subdivisional lines in T. 29 S., R. 8 W., Willamette Meridian, Oregon.

The history of surveys pertaining to this retracement is as follows:

In 1855, Dennis Hathorn, U.S. Deputy Surveyor, surveyed the subdivisional lines.

In 1856, A. J. Burnett, U.S. Deputy Surveyor, surveyed numerous Donation Land Claims in the Tp.

In 1965, Donald R. Beck, Cadastral Surveyor, resurveyed a portion of the subdivisional lines and subdivided section 31.

In 2001, A. Bert Skeesick, Cadastral Surveyor, resurveyed a portion of the subdivisional lines and subdivided section 32.

In 2004, A. Bert Skeesick and Timothy J. Moore, Cadastral Surveyors, resurveyed a portion of the subdivisional lines and subdivided section 29.

In 2006, A. Bert Skeesick, Cadastral Surveyor, resurveyed a portion of the subdivision of section lines of section 29, and further subdivided section 29.

This retracement was executed by A. Bert Skeesick, Cadastral Surveyor, beginning May 8, 2006, and completed May 8, 2006, pursuant to Special Instructions for Group 2100, dated March 8, 2004, and Group 2300, dated March 16, 2007; under Assignment Instructions dated May 8, 2006, and Group 2100 re-Assignment dated March 16, 2007. He was assisted by Robert Durning and Dameon P. Barrows, Surveying Technicians.


The retracement data were thoroughly verified and only the true line data is given hereon.

The direction of the line is based on the true meridian as determined by direct solar observations.

An analysis of the unadjusted field data assured a closure not exceeding 1:4000 in error. Measured distances and directions have been adjusted by computer software that incorporates a least squares adjustment routine. The adjusted bearings and distance are reported to the nearest second and 0.01 foot.

The descriptions of the corners are as reported by Skeesick in 2001, and Moore and Skeesick in 2004.

I, A. Bert Skeesick, Cadastral Surveyor, HEREBY CERTIFY upon honor, that in pursuance of Special Instructions bearing date of the 8th day of March, 2004, and the 16th day of March, 2007, I have retraced of a portion of the subdivisional lines in Township 29 South, Range 8 West, of the Willamette Meridian, in the State of Oregon, which is represented upon this plat as having been executed by me and under my direction. Said survey has been made in strict conformity with said Special Instructions, the Manual of Instructions for the Survey of the Public Lands of the United States, and in specific manner described upon this plat.

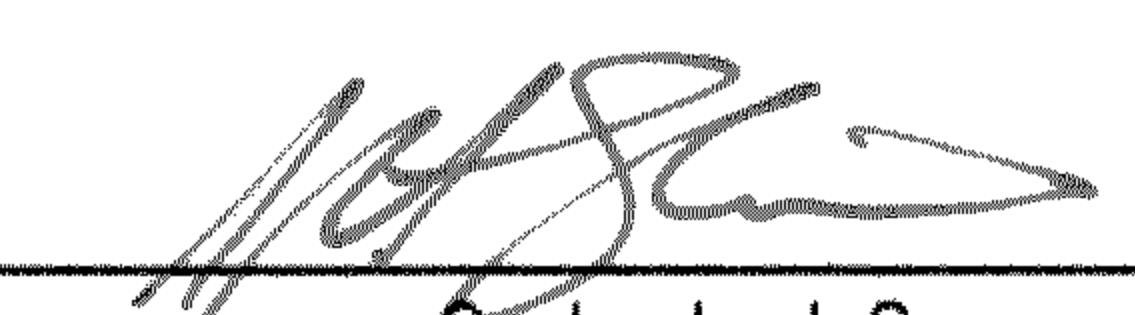
 Cadastral Surveyor
 4/23/2008 Date

UNITED STATES DEPARTMENT OF THE INTERIOR
 BUREAU OF LAND MANAGEMENT


Portland, Oregon

The retracement represented by this plat, having been correctly executed in accordance with the requirements of law and the regulations of this Bureau, is hereby accepted.

For the Director

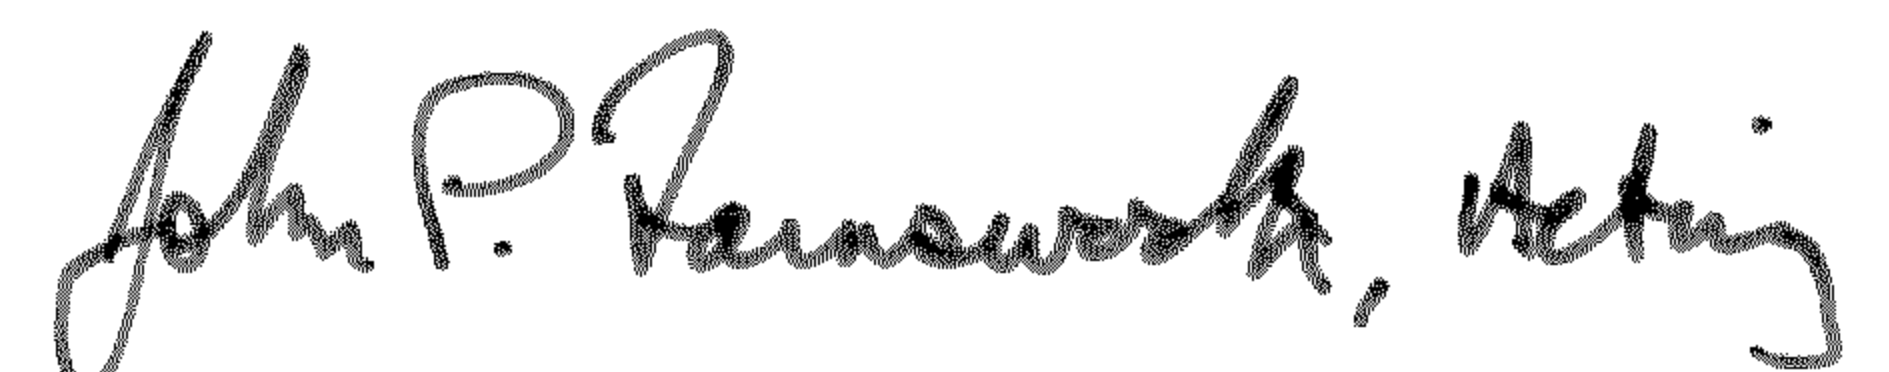
 Chief Cadastral Surveyor of Oregon

NOTE: THERE ARE NO SEPARATE LINE NOTES TO GO WITH THIS RETRACEMENT - ALL THE AVAILABLE INFORMATION IS ON THIS PLAT.

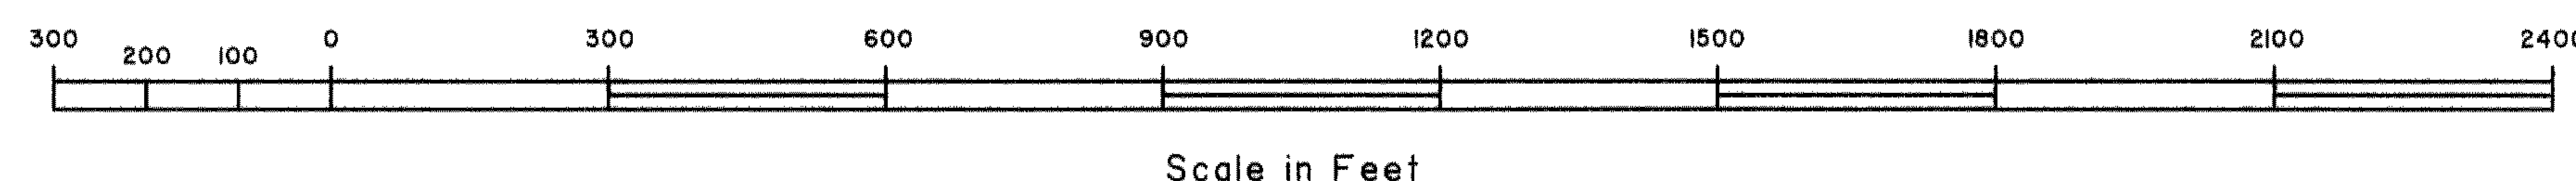

April 7, 2008
 Date