

TOWNSHIP 30 SOUTH, RANGE 9 WEST, OF THE WILLAMETTE MERIDIAN, OREGON


DEPENDENT RESURVEY



Mean magnetic declination  
19° EAST

Sec. 5

Sec. 4

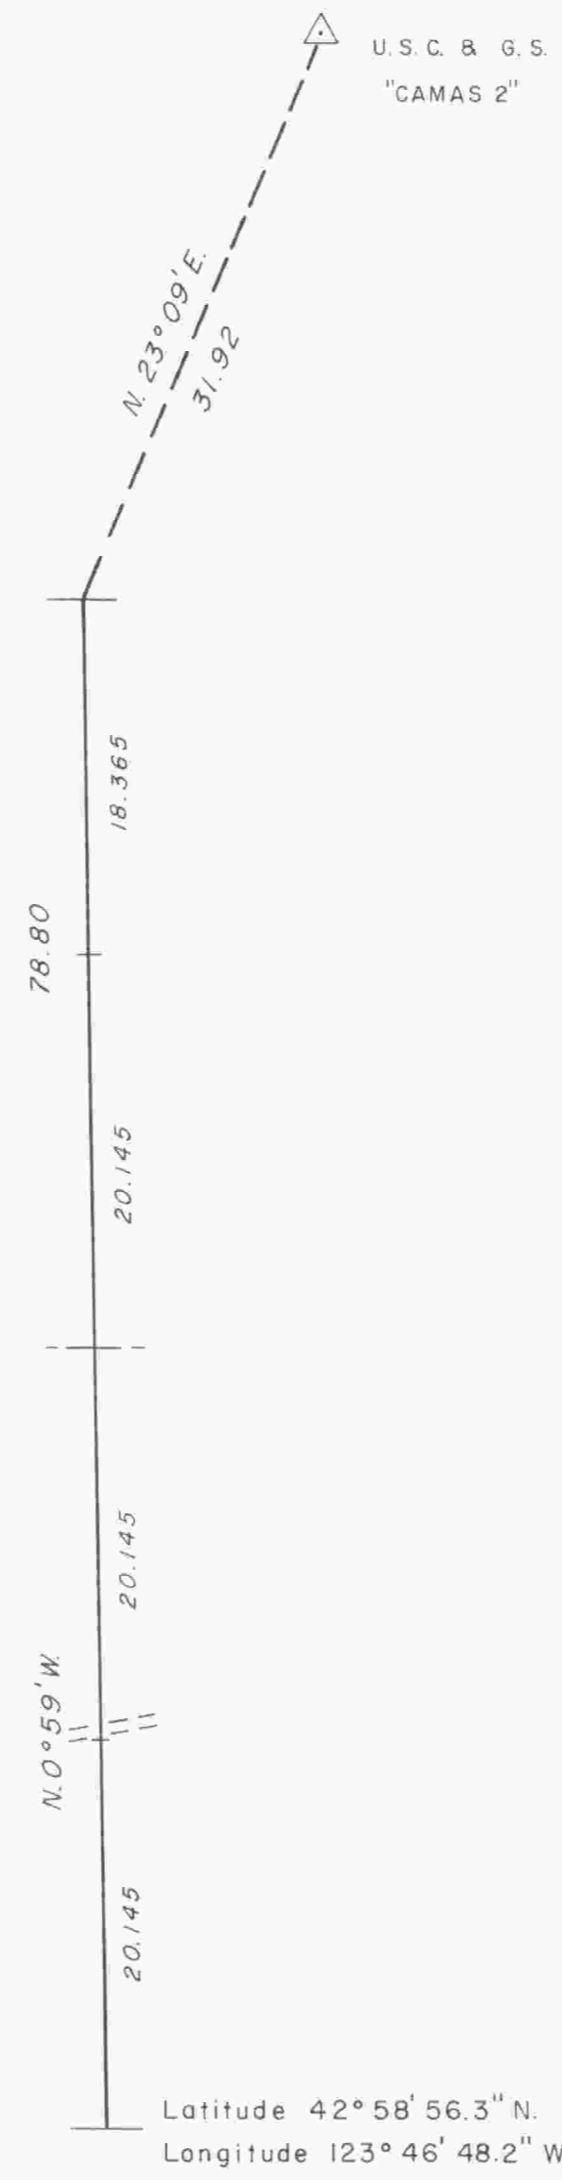

A history of surveys is contained in the field notes.

This plat represents a dependent resurvey of a portion of the subdivisional lines, T. 30 S., R. 9 W., Willamette Meridian, Oregon, designed to restore the corners in their true original locations according to the best available evidence.

The survey was executed by Harvey E. Wofford, Cadastral Surveyor, beginning July 14, 1980, and completed July 24, 1980, pursuant to Special Instructions dated March 25, 1980, for Group No. 1023, Oregon.

Timber in this area consists of fir, hemlock, and cedar.

UNITED STATES DEPARTMENT OF THE INTERIOR  
BUREAU OF LAND MANAGEMENT  
Portland, Oregon May 11, 1984

This plat is strictly conformable to the approved field notes, and the survey, having been correctly executed in accordance with the requirements of law and the regulations of this Bureau, is hereby accepted.

For the Director

*William W. Glenn*

Chief Cadastral Surveyor of Oregon

