

TOWNSHIP 33 SOUTH, RANGE 5 WEST, OF THE WILLAMETTE MERIDIAN, OREGON.

DEPENDENT RESURVEY

Sec. 4

Sec. 3

Sec. 2



Sec. 9

Sec. 10

Sec. 11



Mean
Magnetic
Declination
19°33' East

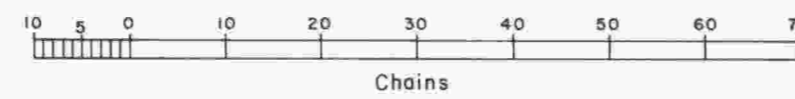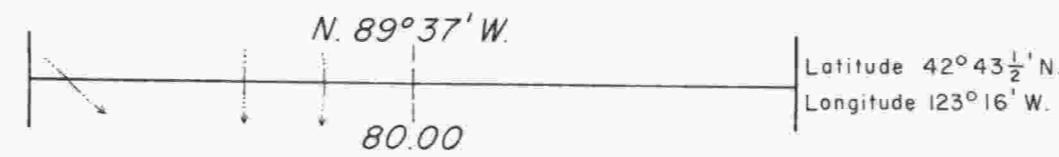

This plat represents a retracement and reestablishment of a portion of the subdivisional lines designed to restore the corners in their true original location according to the best available evidence.

The subdivisional lines were surveyed by Edward F. Sharp in 1894.

Dependent resurvey of the line between secs. 3 and 10, T. 33 S., R. 5 W., Willamette Meridian, Oregon, executed by Hans W. Thielsön, November 20 to 22, 1957, under special instructions dated October 24, 1957, which provide for the surveys included under Group 390, Oregon.

Timber in this area consists of Douglas fir, pine, oak, cedar, yew, madrona, and chinquapin.

UNITED STATES DEPARTMENT OF THE INTERIOR
BUREAU OF LAND MANAGEMENT
Washington, D. C. August 7, 1958

This plat is strictly conformable to the approved field notes, and the survey, having been correctly executed in accordance with the requirements of law and the regulations of this Bureau, is hereby accepted.

For the Director

Earl G. Harrington
Cadastral Engineering Staff Officer