

TOWNSHIP 33 SOUTH, RANGE 6 WEST, OF THE WILLAMETTE MERIDIAN, OREGON.

DEPENDENT RESURVEY

This plat represents a dependent resurvey of a portion of the subdivisional lines, T. 33 S., R. 6 W., Willamette Meridian, Oregon, designed to restore the corners in their true original locations according to the best available evidence.

A portion of the subdivisional lines was surveyed by Wells Lake and George W. Hyde, in 1855.

The survey of the subdivisional lines was completed by William H. Byars, in 1882.

A portion of the subdivisional lines was resurveyed and section 24 was subdivided by Lynn M. Roseberry, in 1970.

Survey executed by Lynn M. Roseberry, Cadastral Surveyor, from August 9, 1973 to August 14, 1973, under Special Instructions dated July 9, 1973, which provided for the surveys included under Group No. 817, Oregon.

UNITED STATES DEPARTMENT OF THE INTERIOR
BUREAU OF LAND MANAGEMENT
Washington, D.C. September 20, 1977

This plat is strictly conformable to the approved field notes, and the survey, having been correctly executed in accordance with the requirements of law and the regulations of this Bureau, is hereby accepted.


For the Director

Bernard W. Forster
Chief, Division of Cadastral Survey




Sec. 26

Sec. 25

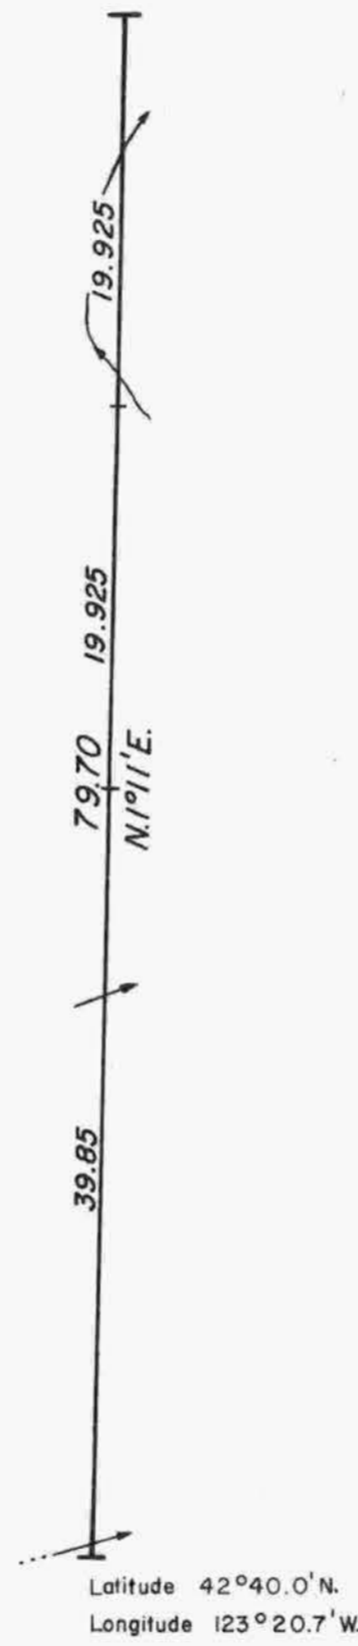

Latitude 42°40.0'N.
Longitude 123°20.7'W.

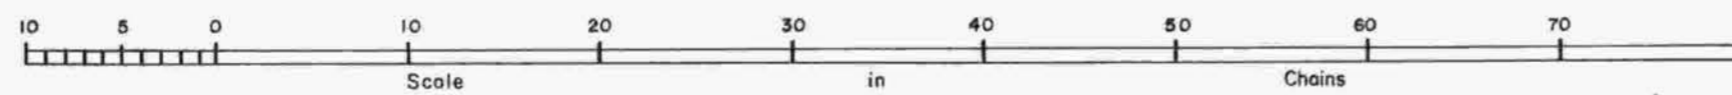

Timber in this area consists of fir, pine, cedar, madrone, yew, maple, alder, and chinquapin.