

N T. G. ...
W. S. ...
R. L. ...
W. ...
W. E. ...
#11

SE Cor cl 38. Top 27-3 or cl 39 - Top 27-4.
Set corner from running East from internal "L"
Corner of cl 39 and making tie to deep line
between Sec 1 & 6. Set 1 1/2" x 36" Gernul to a
Curly Reaper. Marked 8" W.O. N 51° E 54.9 feet
12" W.O. N 52° W 82.5 feet

W. B. ...
W. ...
W. ...
#12

Sec. Corner $\frac{15}{22} \frac{14}{23}$
Identified location by old post badly rotted and all
original BT's. Set a new 4" Fir Post for corner.
Reblazed and scribed all original BT's.

W. B. ...
W. ...
W. ...
#14


1/4 Sec. Cor North Side Sec. 6
Identified location from Original BT's. Drove 1 1/4" Iron
pipe for corner from which 16" Fir bears S 55° E 144 ft
18" fir bears N 31° 33' E 66'

1/4 Sec. Cor. between Secs 5 & 6

Identified location from Original BT's. Set a fir post for
corner from which a 10" Fir bears S 25° E 105 ft
14" " " N 30° W 33 ft. OBT.

Arthur Boyer D.C.S.
Wit. N.E. Richardson
T. V. Gurney
Jno La Bonte
O. J. Noice
#15

Sec Cor $\frac{2}{11} \frac{1}{12}$ Found Trees in NE ^{Sec I} and SW ^{Sec. II} quadrants OK. but scribe
marks gone so that they are hard to read but could be identified
so renewed scribe marks on these trees. found Laurel gone (Sec. 2)
except for stump so renewed it: Maple in Sec 12 gone renewed
tree for this quadrant. Set fir post, & set pile of Rocks for Corner
from which 8" Cedar brs. N 58 1/2° W 12.5'
14" Maple " East 48.7'

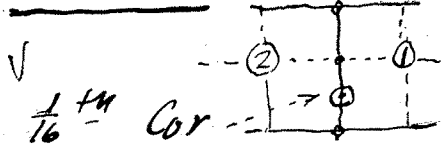

Set Fir Post and Pile of Rocks for Corner from which
a 12" oak stump brs. S 80 1/2° W 70.9'
36" Pine " " N 37 1/2° E. 84.0'

Arthur Boyer D.C.S.

Arthur Boyer D.C.S.

Arthur Boyer D.C.S.

Arthur Boyer D.C.E. Mar 1936
Wit. { N.E. Richardson
T.V. Gurnee
O.J. Noice
S.J. "
same as shown above

35 | 36 T26-3
T272
T273
✓ Sec Cor. 2 | 1

Identified location from scribe marks on Oak Tree, which was down, tree was in Sec 2, found Stump hole and cut out scribed face, No other evidence


Set fir post and rocks for corner from which
a 12" Fir Brs. N.36°W. 8.0'

15" " " N.11°E. 1.75'

12" " " S. 72°W 19.0'

20" " " S 34°E 22.5'

#16

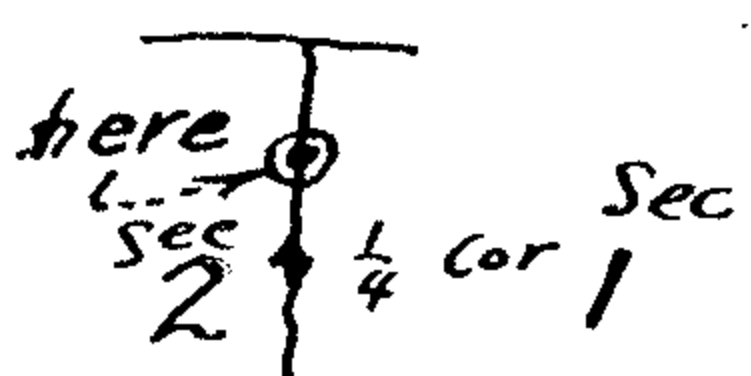✓ 1/16th Cor abt 1/4 mi N of 1/4 Cor 

Set post, fir for corner

from which 12" Fir brs. S.61°E. 18.7'

40" Pine " S 20°W. 34.6'

#17

Arthur Boyer D.C.E.
Wit. { N.E. Richardson
T.V. Gurnee
Jno LaBonte
O.J. Noice

✓ 1/4 Cor bet Sec's. 1 & 2

Identified loc'n from oak stump, which has been burnt, the tree of Jno LaBonte and T.V. Gurnee testify that this was the orig B.T. for Sec 1 - Set fir post and pile rocks for corner from which a

40" Bark Blazed Fir Brs. N51°E 80.0'

40" " " " " S63°W 46.2'

#18

5 | 4 T27-3
8 | 9
✓ Sec Cor.

Location identified from all four of the original Bearing trees as follows.

A Laurel 16" dia. S1°W 50 lks, Laurel 30" dia. S55E. 45 lks.

Fir 24" dia. N45°W 15 lks, instead of N10°W as recorded

& Fir 48" dia. N10°E — lks instead of N15°E. 30 lks.

Set a Yew Wood Post 3" x 3" x 48" for corner

The original fir Bearing trees were reblazed in the Bark & scribed.

A Cedar 10" dia. S.30°E. 29 lks.

A Double white Fir 24" dia S50°W 46 lks

B.B. Irving D.C.S.
Wit. { N.E. Richardson
N.G. Williams
Bert Delzene
AUG 12-1939
#19