


T.25 S., R. 2 E #

CORNERS RENEWED BY
 BUREAU OF LAND MANAGEMENT -----◆
 COUNTY SURVEYOR'S OFFICE -----⊙
 PRIVATE SURVEYORS -----○
 CORNERS FOUND AND USED -----■
 CORNERS LOOKED FOR AND NOT FOUND -----●

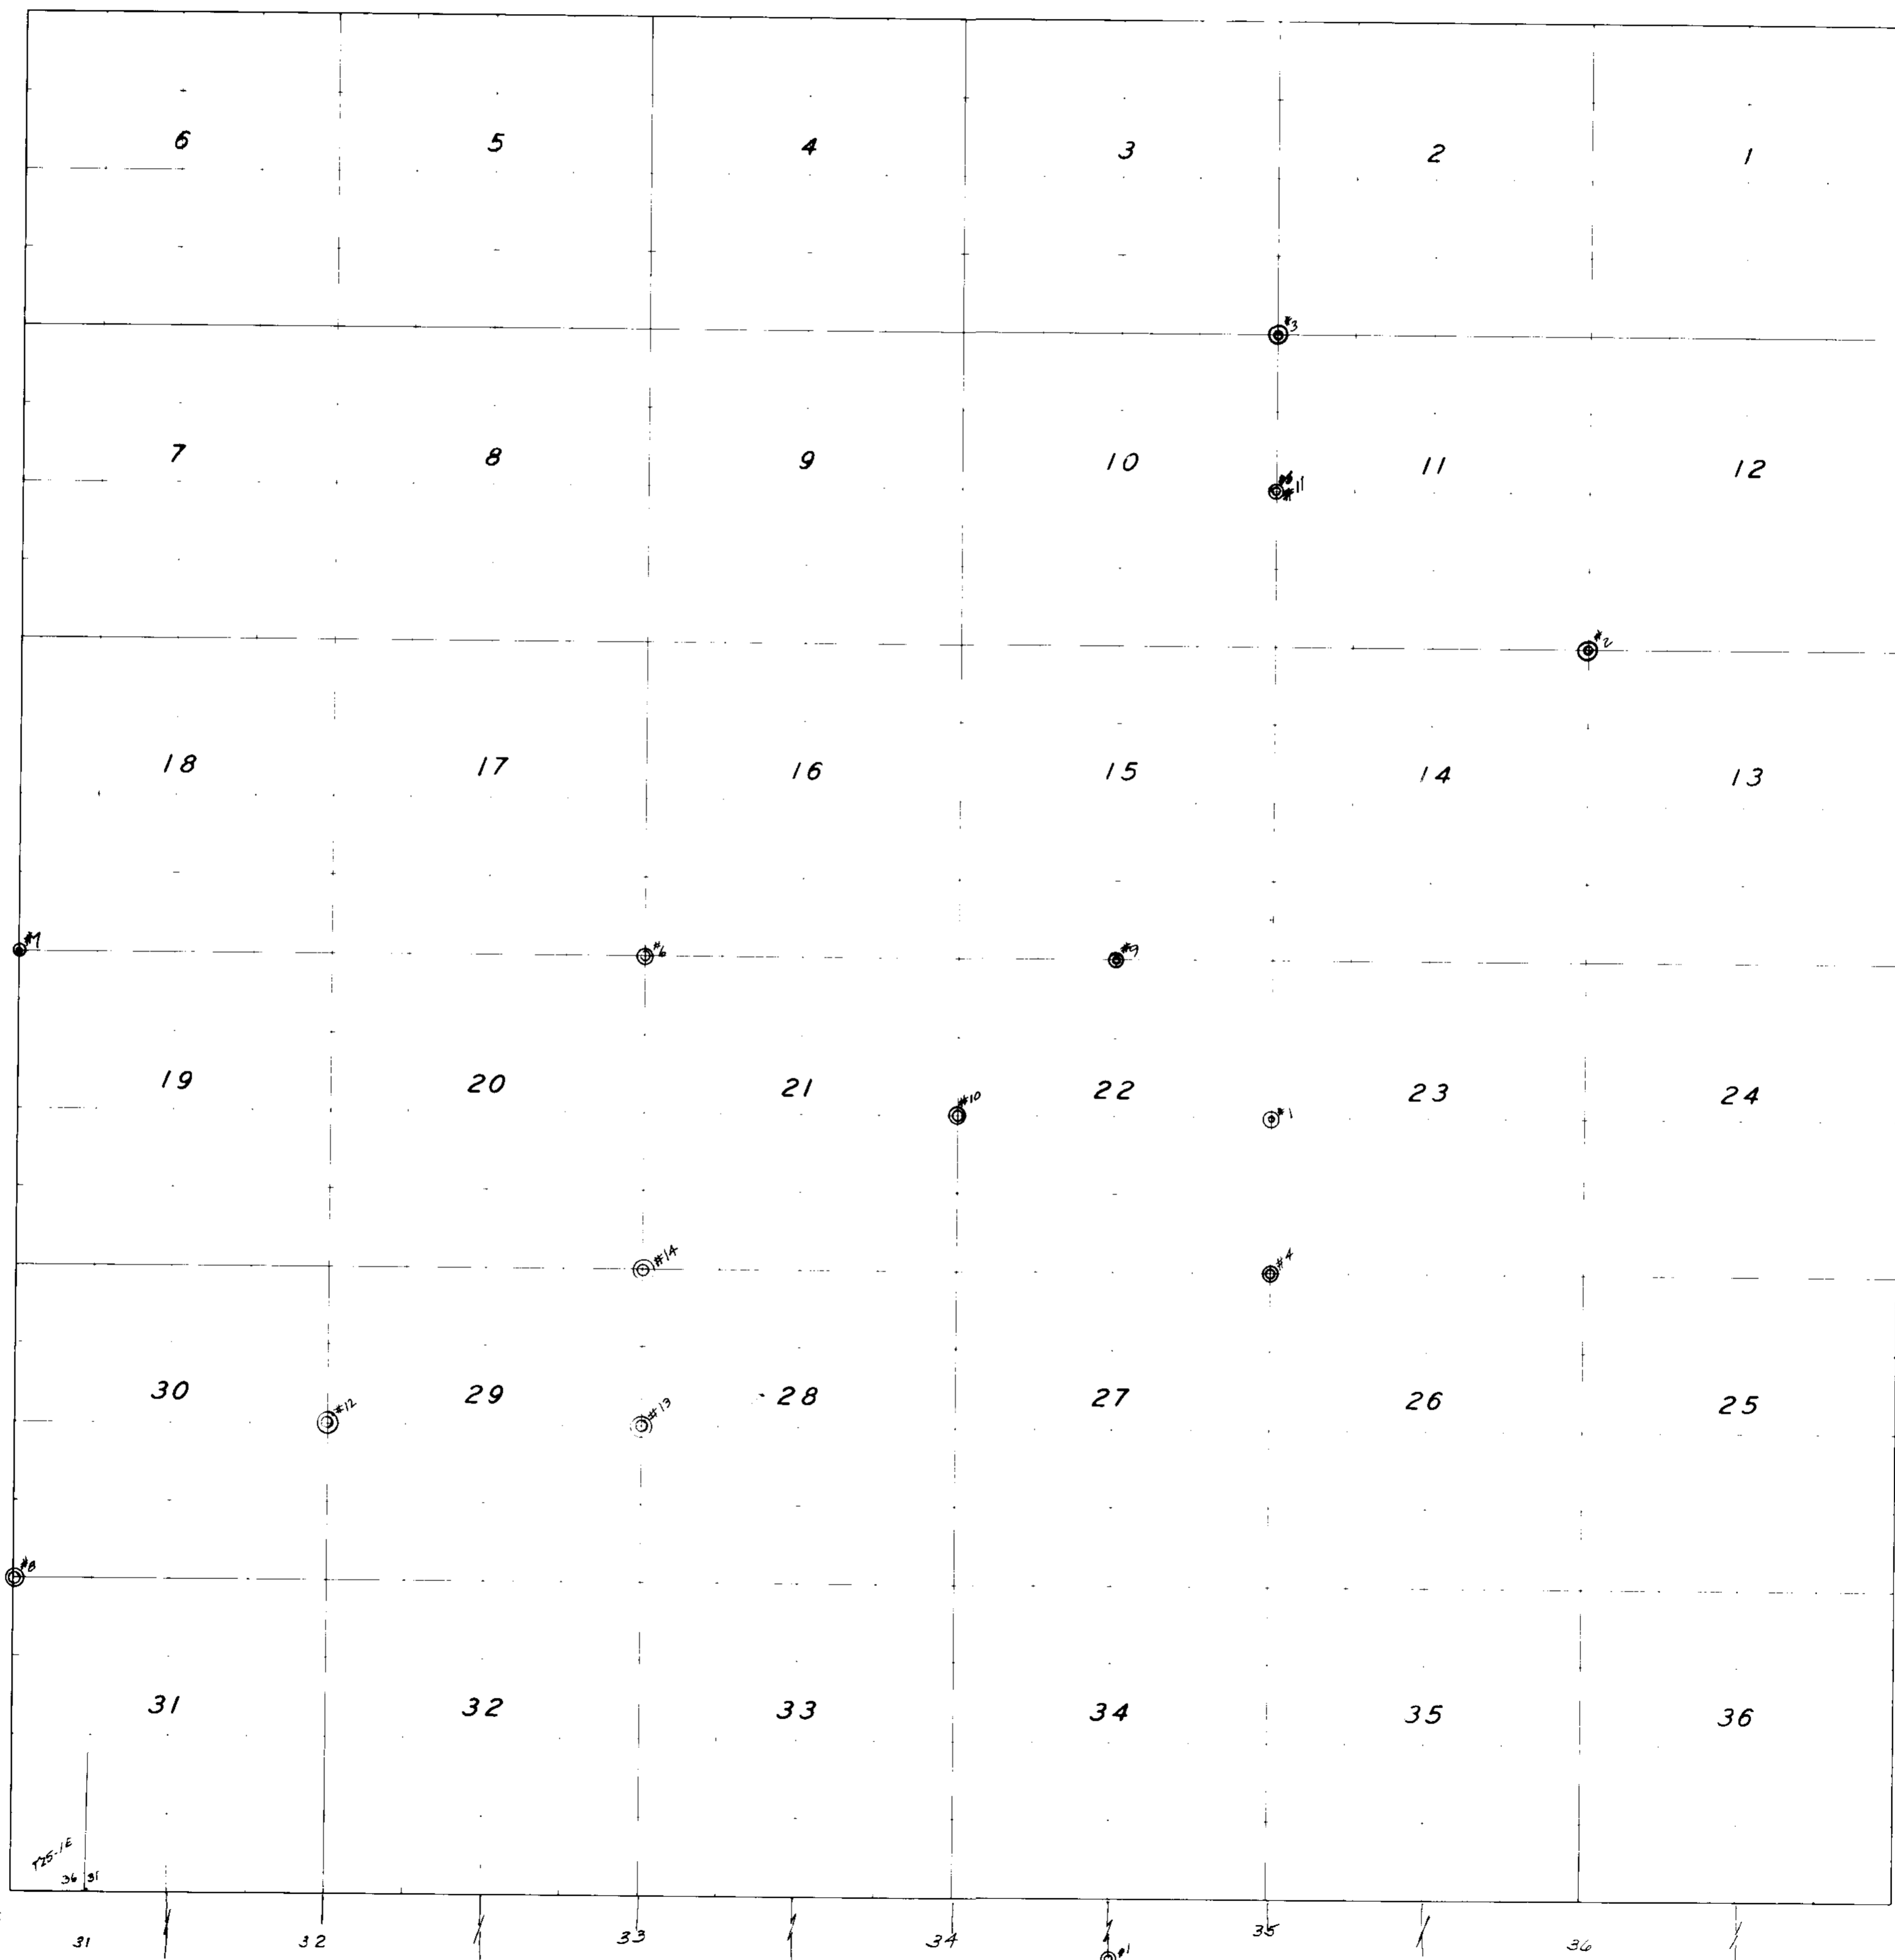

R 1 E

T 25 1/2 S
R 2 E

T 25 1/2 S
36 31