


T. 25 1/2 S., R. 3 E.

CORNERS RENEWED BY
BUREAU OF LAND MANAGEMENT -----◆
COUNTY SURVEYOR'S OFFICE -----⊙
PRIVATE SURVEYORS -----○
CORNERS FOUND AND USED -----■
CORNERS LOOKED FOR AND NOT FOUND -----●

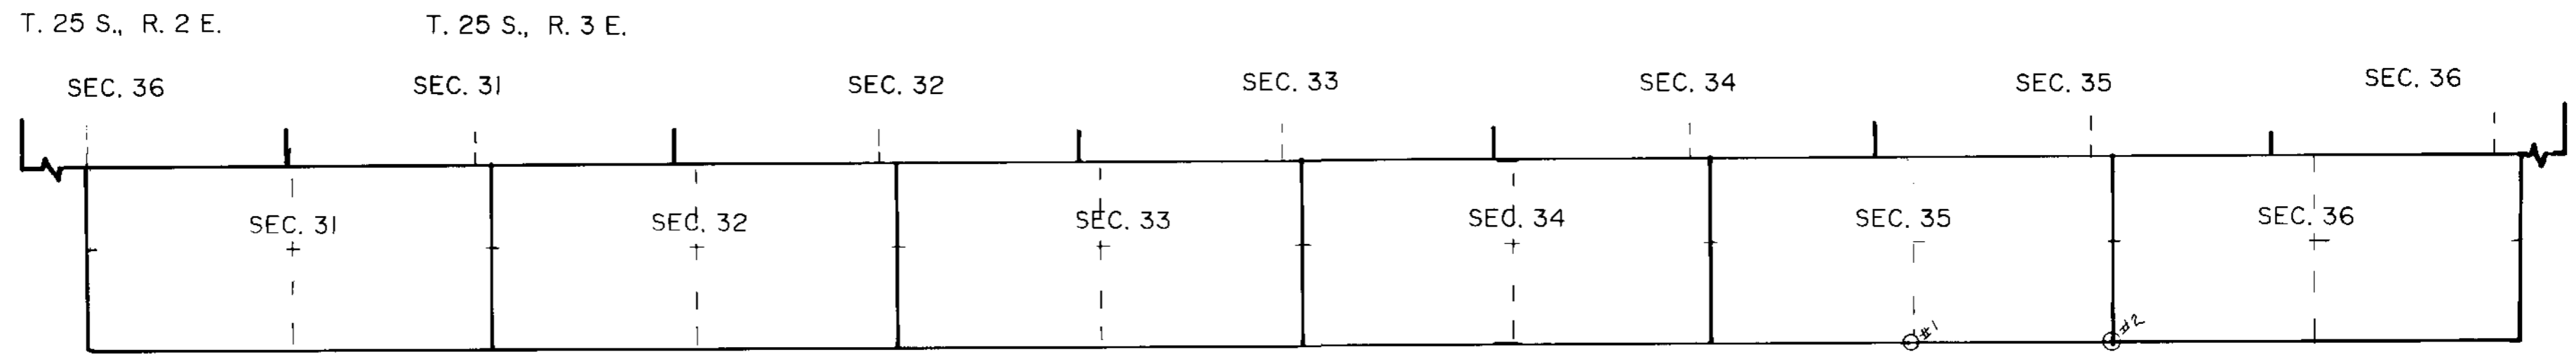

T. 26 S., R. 3 E.