

Douglas County Surveyor's Record of  
Government Corners Renewed

26 T. S. 2 E. R/W/W. M.

Corner No. 3, H. E. S. 142. 9

Corner is monumented with a Basalt Stone 12x7x7" above the ground, mkd. X on top, 3 HES 142 on the side facing the claim, from which the only extant Orig. BT:

22" Y. Pine bears S.16 $\frac{1}{2}$ °E. 53 lks., healed.  
New BT: D. Fir 18" bears N.22°E. 79 lks. mkd. 3 HES 142 RS404 BT. 25

Corner No. 4, H. E. S. 142. 10

Corner is monumented with a basalt stone 12x8x8" above the ground, mkd. X on top, 4 HES 142 on the side facing the claim, from which the original bearing trees: 26

18" D. Fir Stump bears N.22°10'E. 135 lks. with blaze healed.  
34" D. Fir bears S.37 $\frac{1}{2}$ °E. 185 lks. with blaze healed.  
New BT: 16" D. Fir bears S.62°W. 12 lks. mkd. 4 HES 142 RS404 BT.

Corner No. 1, H. E. S. 93. 11

Corner common with A P 1, Bates Tract. #60  
The corner stone has been disturbed by the construction of a power line; determine the corner point from the Orig. BT's:

32" D. Fir sawed stump bears N.38 $\frac{1}{2}$ °E. 94 lks. with partial scribe marks.  
36" D. Fir sawed Stump bears S.11 $\frac{1}{2}$ °E. 63 lks., I open & find mkd. BT.

Set an I. P/ 3' long 1 $\frac{1}{2}$ " diam., 28" in the gr. mkd. RS404 from which:  
14" Y. Pine bears N.7 $\frac{1}{2}$ °E. 133 lks. mkd. 1 HES 93 RS404 BT.  
16" D. Fir bears S. 9°W. 164 lks. mkd. 1 HES 93.

Corner No. 9, H. E. S. 93. 12

The corner stone has been disturbed by a logging operation; determine the cor. point from the Orig. BT's: #67

30" D. Fir sawed stump bears N.48°W. 29 lks. mkd. 9 HES 93 BT.  
36" D. Fir sawed stump bears N. 8 $\frac{1}{2}$ °E. 76 lks. with blaze healed.  
Set an I. P. 3' long 1 $\frac{1}{2}$ " diam., 28" in the gr. mkd. RS404 from which:  
18" D. Fir bears N.81 $\frac{1}{2}$ °W. 68 lks. mkd. 9 HES 93 RS404 BT.  
8" D. Fir bears S.79°E. 31 lks. mkd. 9 HES 93 RS404 BT.

Corner No. 2, H.E.S. 93 common with A P 2, Bates Tract. 13

The corner point is determined from the only extant orig. BT:

40" D. Fir bears S.88°E. 105 $\frac{1}{2}$  lks., I open & find "B", leave other mks. healed. #61  
Set an I. P. 3' long 1 $\frac{1}{2}$ ", 3" below the surface of road bed from which:  
24" D. Fir bears N.81 $\frac{1}{2}$ °W. 95 lks. mkd. 2 HES 93 RS404 BT.  
10" D. Fir bears N.69°E 61 lks. mkd. 2 HES 93 RS404 BT.

OCT. 1969 - FOUND O.K. C.S. 52/43 V.R.T.

Corner No. 3, H.E.S. 93. 14

A basalt boulder in place 5 ft. NE & SW, 3' NW & SE, flush with a fill. The reference points have been destroyed. 17A

New BT's: 16" D. Fir bears S. 2°E., 9 lks. mkd. 3 HES 93 RS404 BT  
12" D. Fir bears N.13°E., 41 lks. mkd. 3 HES 93 RS404 BT.

MICROFILM TO HERE 10/67

Section Corner to Sections 22 - 23 - 26 - 27. 15


Found - 1929 GLO Brass Cap set in Rock, properly marked. 45

Orig. 20", now 24" Fir, alive, N.47°E. (Record N.57°E.) 17.2 ft. shows good scar, we do not open.  
Orig. 44", now 48" Fir, dead, S.45°E. 66.7 ft., shows scar, don't open.  
Orig. 10", now 10" Yew, dead, S.33°W. 33.0 ft., scribe visible on unhealed blaze.  
Orig. 30", now 32" Fir, alive, N.37°W. 16.5 ft., shows good scar.  
New BT's: 9" D. Fir S.43°W. 18.0 ft. mkd. T26S R2E S27 CS BT.  
9" D. Fir S.22°E. 21.7 ft. mkd. T26S R2E S26 CS BT.

Note - This corner lies on steep, easterly slope 25 ft. E. of bottom of 20 ft. high bluff.

2/13/68

Marvin C. Ramsey  
For J. H. Baxter & Co. of Roseburg, Ore.  
Wit: J. Goodin & R. Schultz  
Sept. 12-22, 1960  
C. S. File No. 51/126

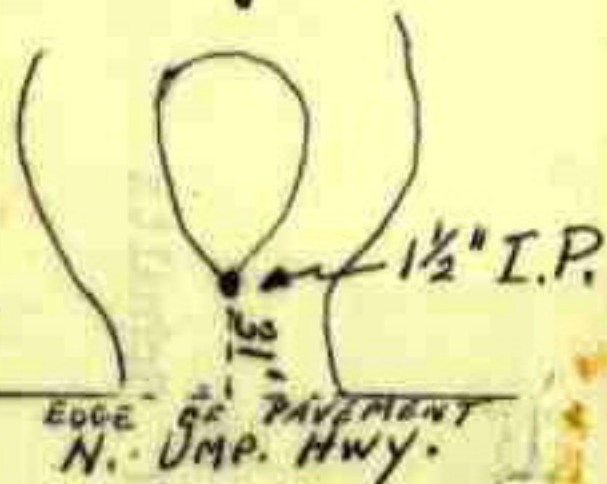

Vernon "Ray" Tracy  
J. Heritage & V. Perron  
Feb. 13, 1968  
C.S. File No. 52/43